



DEPARTMENT OF REGULATORY AND ECONOMIC RESOURCES (RER)  
BOARD AND CODE ADMINISTRATION DIVISION  
**NOTICE OF ACCEPTANCE (NOA)**

MIAMI-DADE COUNTY, FLORIDA  
PRODUCT CONTROL SECTION  
11805 S.W. 26<sup>th</sup> Street, Room 208  
Miami, Florida 33175-2474  
T (786) 315-2590 F (786) 315-2599  
<http://www.miamidade.gov/economy/>

**Nan Ya Plastics Corporation USA**  
8989 North Loop East  
Suite 800  
Houston, TX 77029-1217

**SCOPE:**

This NOA is being issued under the applicable rules and regulations governing the use of construction materials. The documentation submitted has been reviewed and accepted by Miami-Dade County RER-Product Control Section to be used in Miami-Dade County and other areas where allowed by the Authority Having Jurisdiction (AHJ).

This NOA shall not be valid after the expiration date stated below. The Miami-Dade County Product Control Section (In Miami-Dade County) and/or the AHJ (in areas other than Miami-Dade County) reserve the right to have this product or material tested for quality assurance purposes. If this product or material fails to perform in the accepted manner, the manufacturer will incur the expense of such testing and the AHJ may immediately revoke, modify, or suspend the use of such product or material within their jurisdiction. RER reserves the right to revoke this acceptance, if it is determined by Miami-Dade County Product Control Section that this product or material fails to meet the requirements of the applicable building code. This product is approved as described herein, and has been designed to comply with the Florida Building Code, including the High Velocity Hurricane Zone.

**DESCRIPTION:**

**Series "Impact" 8Ft. P/E Outswing Glazed White PVC/Fiberglass French Door w/ Sidelites-L.M.I.**

**APPROVAL DOCUMENT:** Drawing No. NAN0021, Series titled "Impact 8' Glazed Outswing Double Door w/ Sidelites", sheets 1 through 11 of 11, dated 05/22/09, with revision "B" dated 04/25/12, prepared by PTC, LLC, signed and sealed by Robert James Amoroso, P. E., bearing the Miami-Dade County Product Control Section revision stamp with the Notice of Acceptance number and expiration date by the Miami-Dade County Product Control Section.

**MISSILE IMPACT RATING: Large and Small Missile Impact.**

**LIMITATION: 1.** SinP. glazed sidelites are limited to glazing detail 3 on sheet 06 of 11.

**2.** SinP. glazed sidelites are limited to maximum 15 $\frac{3}{8}$ "Width by 95 $\frac{1}{4}$ "Height.

**LABELING:** Each unit shall bear a permanent label with the manufacturer's name or logo, **Taipei, Taiwan, Republic of China**, series, and following statement: "Miami-Dade County Product Control Approved", unless otherwise noted herein.

**RENEWAL** of this NOA shall be considered after a renewal application has been filed and there has been no change in the applicable building code negatively affecting the performance of this product.

**TERMINATION** of this NOA will occur after the expiration date or if there has been a revision or change in the materials, use, and/ or manufacture of the product or process. Misuse of this NOA as an endorsement of any product, for sales, advertising or any other purposes shall automatically terminate this NOA. Failure to comply with any section of this NOA shall be cause for termination and removal of NOA.

**ADVERTISEMENT:** The NOA number preceded by the words Miami-Dade County, Florida, and followed by the expiration date may be displayed in advertising literature. If any portion of the NOA is displayed, then it shall be done in its entirety.

**INSPECTION:** A copy of this entire NOA shall be provided to the user by the manufacturer or its distributors and shall be available for inspection at the job site at the request of the Building Official.

This NOA revises NOA No. 09-0312.15 and consists of this page 1 and evidence pages E-1, E-2, E-3 and E-4, as well as approval document mentioned above.

The submitted documentation was reviewed by **Jaime D. Gascon, P. E.**



*J. Gascon*  
9/25/12

NOA No. 12-0612.13  
Expiration Date: July 22, 2014  
Approval Date: October 04, 2012  
Page 1

**Nan Ya Plastics Corporation USA**

**NOTICE OF ACCEPTANCE: EVIDENCE SUBMITTED**

**A. DRAWINGS**

1. Manufacturer's die drawings and sections.  
*(Submitted under previous NOA No. 09-0312.15)*
2. Drawing No. **NAN0021**, Series titled "Impact 8' Glazed Outswing Double Door w/ Sidelites", sheets 1 through 11 of 11, dated 05/22/09, with revision "**B**" dated 04/25/12, prepared by PTC, LLC, signed and sealed by Robert James Amoruso, P. E.

**B. TESTS**

1. Test report on: 1) Air Infiltration Test, per FBC, TAS 202-94  
2) Uniform Static Air Pressure Test, Loading per PA 202-94  
3) Water Resistance Test, per FBC, TAS 202-94  
4) Large Missile Impact Test per FBC, TAS 201-94  
5) Cyclic Wind Pressure Loading per FBC, TAS 203-94  
6) Forced Entry Test, per FBC 2411 3.2.1 and TAS 202-94  
along with marked-up drawings and installation diagram of Fiberglass Outswing Opaque/ Glazed Door w/wo Sidelites, prepared by Certified Testing Laboratories, Inc., Test Report No. **CTLA 1908W**, dated 12/30/08, signed and sealed by Ramesh Patel, P. E.  
*(Submitted under previous NOA No. 09-0312.15)*

**C. CALCULATIONS**


1. Anchor calculations and structural analysis, complying with FBC, prepared by PTC Engineering, Inc., dated 05/27/09, signed and sealed by Paul E. Winter, P. E.  
*(Submitted under previous NOA No. 09-0312.15)*
2. **Complies with ASTM E1300-02/ 04**

**D. QUALITY ASSURANCE**

1. Miami-Dade Department of Regulatory and Economic Resources (RER).

**E. MATERIAL CERTIFICATIONS**

1. Notice of Acceptance No. **11-1102.11**, issued to **Solutia, Inc.** for their "**Saflex Clear or Color Glass Interlayers**" dated 06/14/12, expiring on 05/21/16.
2. Notice of Acceptance No. **10-1209.01** issued to **ODL, Inc.** for their "**ODL HP Polypropylene Series High Performance Door Lite Material - Component Approval**" dated 01/20/11, expiring on 01/17/16.
3. Test Report No. **ETC-06-255-17412.1**, prepared by ETC Laboratories, dated 04/25/06, re-issued on 07/10/06 to Nan Ya Plastics Corporation USA, for their Phenolic Foam Board/ ETC06013 plastic per ASTM E84-05 "Standard Test Method for Surface Burning Characteristics of Building Materials", signed and sealed by Joseph Labora Doldan, P. E.  
*(Submitted under previous NOA No. 09-0312.15)*

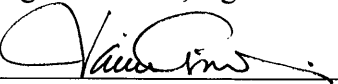  
Jaime D. Gascon, P. E.  
Product Control Section Supervisor  
NOA No. 12-0612.13  
Expiration Date: July 22, 2014  
Approval Date: October 04, 2012

**Nan Ya Plastics Corporation USA**

**NOTICE OF ACCEPTANCE: EVIDENCE SUBMITTED**

**E. MATERIAL CERTIFICATIONS (CONTINUED)**

4. Test reports No.'s **CTLA-1042W** and **CTLA-1042W-1**, prepared by Certified Test Laboratories, Inc., dated 03/21/03, issued by Certified Test Laboratories, Inc., for their aluminum glazed ODL lite-kit doors, Air Infiltration Test, per FBC, TAS 202-94, Uniform Static Air Pressure Test, Loading per FBC, TAS 202-94, Water Resistance Test, per FBC, TAS 202-94, Large Missile Impact Test per FBC, TAS 201-94, Cyclic Wind Pressure Loading per FBC, TAS 203-94 and Forced Entry Test, per FBC 2411.3.2.1 (b) and TAS 202-94 and Tensile test per ASTM E8/A-370, both signed and sealed by Ramesh Patel, P. E. and Lyndon F. Schmidt, P. E.  
*(Submitted under previous NOA No. 09-0312.15)*
5. Test Report No. **ETC-05-255-17900.0**, prepared by ETC Laboratories, dated 06/28/06, issued by Nan Ya Plastics Corporation USA, for their Phenolic Foam Board (P/N: ETC06013), Ignition Properties of Plastics per ASTM D1929-96, signed and sealed by Joseph L. Doldan, P. E.  
*(Submitted under previous NOA No. 09-0312.14)*
6. Test Report No. **ETC-05-255-16776.1**, prepared by ETC Laboratories, dated 07/06/06, issued by Nan Ya Plastics Corporation USA, for their SMC Fiberglass material (P/N: ETC05033), 4500 exposed Xenon Arch & tensile strength per ASTM D 638-03, Tensile strength, ASTM D 638-03, Smoke density per ASTM D2843-99, Rate of burning per ASTM D 635-98, Self ignition per ASTM D1929-01, signed and sealed by Joseph Labora Doldan, P. E.  
*(Submitted under previous NOA No. 09-0312.15)*
7. Test Report No. **ETC-05-255-16777.1**, prepared by ETC Laboratories, dated 07/26/06, issued by Nan Ya Plastics Corporation USA, for their Cellular PVC (P/N: ETC05034), Standard Test Method for Ignition Properties of Plastics per ASTM D1929-96, Standard Test Method for Density of Smoke from the Burning or Decomposition of Plastics per ASTM D2843-99, Standard Test Method for Rate of Burning and/or Extent and Time of Burning of Self-Supporting Plastics in a Horizontal Position per ASTM D635-98, Standard Test Methods for Tensile Properties of Plastics per ASTM D638-03, signed and sealed by Joseph Labora Doldan, P. E.  
*(Submitted under previous NOA No. 09-0312.15)*
8. Test Report No. **ETC-06-255-17412.0**, prepared by ETC Laboratories, dated 04/25/06, issued by Nan Ya Plastics Corporation USA, for their Phenolic Foam Board (P/N ETC06013), Standard Test Method for Surface Burning Characteristics of Building Materials per ASTM E84-05, signed and sealed by Joseph Labora Doldan P. E.  
*(Submitted under previous NOA No. 09-0312.15)*



**Jaime D. Gascon, P. E.**  
**Product Control Section Supervisor**  
**NOA No. 12-0612.13**  
**Expiration Date: July 22, 2014**  
**Approval Date: October 04, 2012**

**NOTICE OF ACCEPTANCE: EVIDENCE SUBMITTED**

**E. MATERIAL CERTIFICATIONS (CONTINUED)**

9. Test Report No. **ETC-05-255-16776.0**, prepared by ETC Laboratories, dated 01/04/06, issued by Nan Ya Plastics Corporation USA, for their SMC (P/N: ETC05033) Standard Test Method for Ignition Properties of Plastics per ASTM D 1929-96, Standard Test Method for Density of Smoke from the Burning or Decomposition of Plastics per ASTM D 2843-99, Standard Test Method for Rate of Burning and/or Extent and Time of Burning of Self-Supporting Plastics in a Horizontal Position per ASTM D 635-98, Standard Test Methods for Tensile Properties of Plastics per ASTM D 638-03, signed and sealed by Joseph Labora Doldan, P. E.  
*(Submitted under previous NOA No. 09-0312.15)*
10. Test Report No. **ETC-05-255-17144.0**, prepared by ETC Laboratories, dated 07/03/08, issued by Nan Ya Plastics Corporation USA, for their Rigid PVC plastic (P/N: ETC06024), Standard Test Method for Ignition Properties of Plastics per ASTM D1929-96, Standard Test Method for Density of Smoke from the Burning or Decomposition of Plastics per ASTM D2843-99, Standard Test Method for Rate of Burning and/or Extent and Time of Burning of Self-Supporting Plastics in a Horizontal Position per ASTM D635-98, Standard Test Methods for Tensile Properties of Plastics for exposed & unexposed sample Xenon Arch after 4500 Hours, per ASTM D638-03, signed and sealed by Joseph Labora Doldan, P. E.  
*(Submitted under previous NOA No. 09-0312.15)*

**F. STATEMENTS**

1. Statement letter of no financial interest, conformance and complying with **FBC-2010**, issued by PTC, LLC, dated 04/25/12, signed and sealed by Robert James Amoruso, P. E.
2. Statement letter dated 09/04/2012, for standard equivalency of ASTM D635-98/ 03 conforming to FBC 2010 for above referenced test reports, issued by PTC, LLC, signed and sealed by Robert James Amoruso, P. E.
3. Laboratory addendum letter for Test Report No. **CTLA 1908W-1**, issued by Certified Testing Laboratories, Inc., dated 05/05/09, signed and sealed by Ramesh Patel, P. E.  
*(Submitted under previous NOA No. 09-0312.15)*
4. Laboratory compliance letters for Test Report No. **CTLA-1908W**, dated 12/30/08, issued by Certified Testing Laboratories, Inc., signed and sealed by Ramesh Patel, P. E.  
*(Submitted under previous NOA No. 09-0312.15)*



Jaime D. Gascon, P. E.  
Product Control Section Supervisor  
NOA No. 12-0612.13  
Expiration Date: July 22, 2014  
Approval Date: October 04, 2012

**Nan Ya Plastics Corporation USA**

**NOTICE OF ACCEPTANCE: EVIDENCE SUBMITTED**

**F. STATEMENTS (CONTINUED)**

5. Laboratory addendum letter for Test Report No. **CTLA 1042W-1**, issued by Certified Testing Laboratories, Inc., dated 03/21/03, signed and sealed by Ramesh Patel, P. E.  
*(Submitted under previous NOA No. 09-0312.15)*
6. Laboratory compliance letters for Test Report No. **CTLA-1042W**, dated 03/21/03, issued by ETC Laboratories, all signed and sealed by Joseph Labora Doldan, P. E.  
*(Submitted under previous NOA No. 09-0312.15)*
7. Laboratory compliance letters for Test Reports No.'s **ETC-06-255-17412.1**, dated 02/15/08, **ETC-05-255-17144.0**, dated 07/03/08, **ETC-05-255-16776.1**, dated 07/06/06, **ETC-06-255-17412.0**, dated 04/25/06, **ETC-05-255-16776.0**, dated 01/04/06, **ETC-05-255-17900.0**, dated 06/28/06 and **ETC-05-255-16777.1**, dated 07/26/06, all issued by ETC Laboratories, all signed and sealed by Joseph Labora Doldan, P. E.  
*(Submitted under previous NOA No. 09-0312.15)*
8. Proposal No. **07-3867**, issued by Product Control, dated 11/27/06, signed by Ishaq Chanda, P. E.  
*(Submitted under previous NOA No. 09-0312.15)*


**G. OTHERS**

1. Notice of Acceptance No. **09-0312.15**, issued to Nan Ya Plastics Corporation USA for their "**Nan Ya Series White PVC/ Fiberglass Glazed Outswing Door w/ Sidelites - L.M.I.**", approved on 07/22/09 and expiring on 07/22/14.




**Jaime D. Gascon, P. E.**  
**Product Control Section Supervisor**  
**NOA No. 12-0612.13**  
**Expiration Date: July 22, 2014**  
**Approval Date: October 04, 2012**



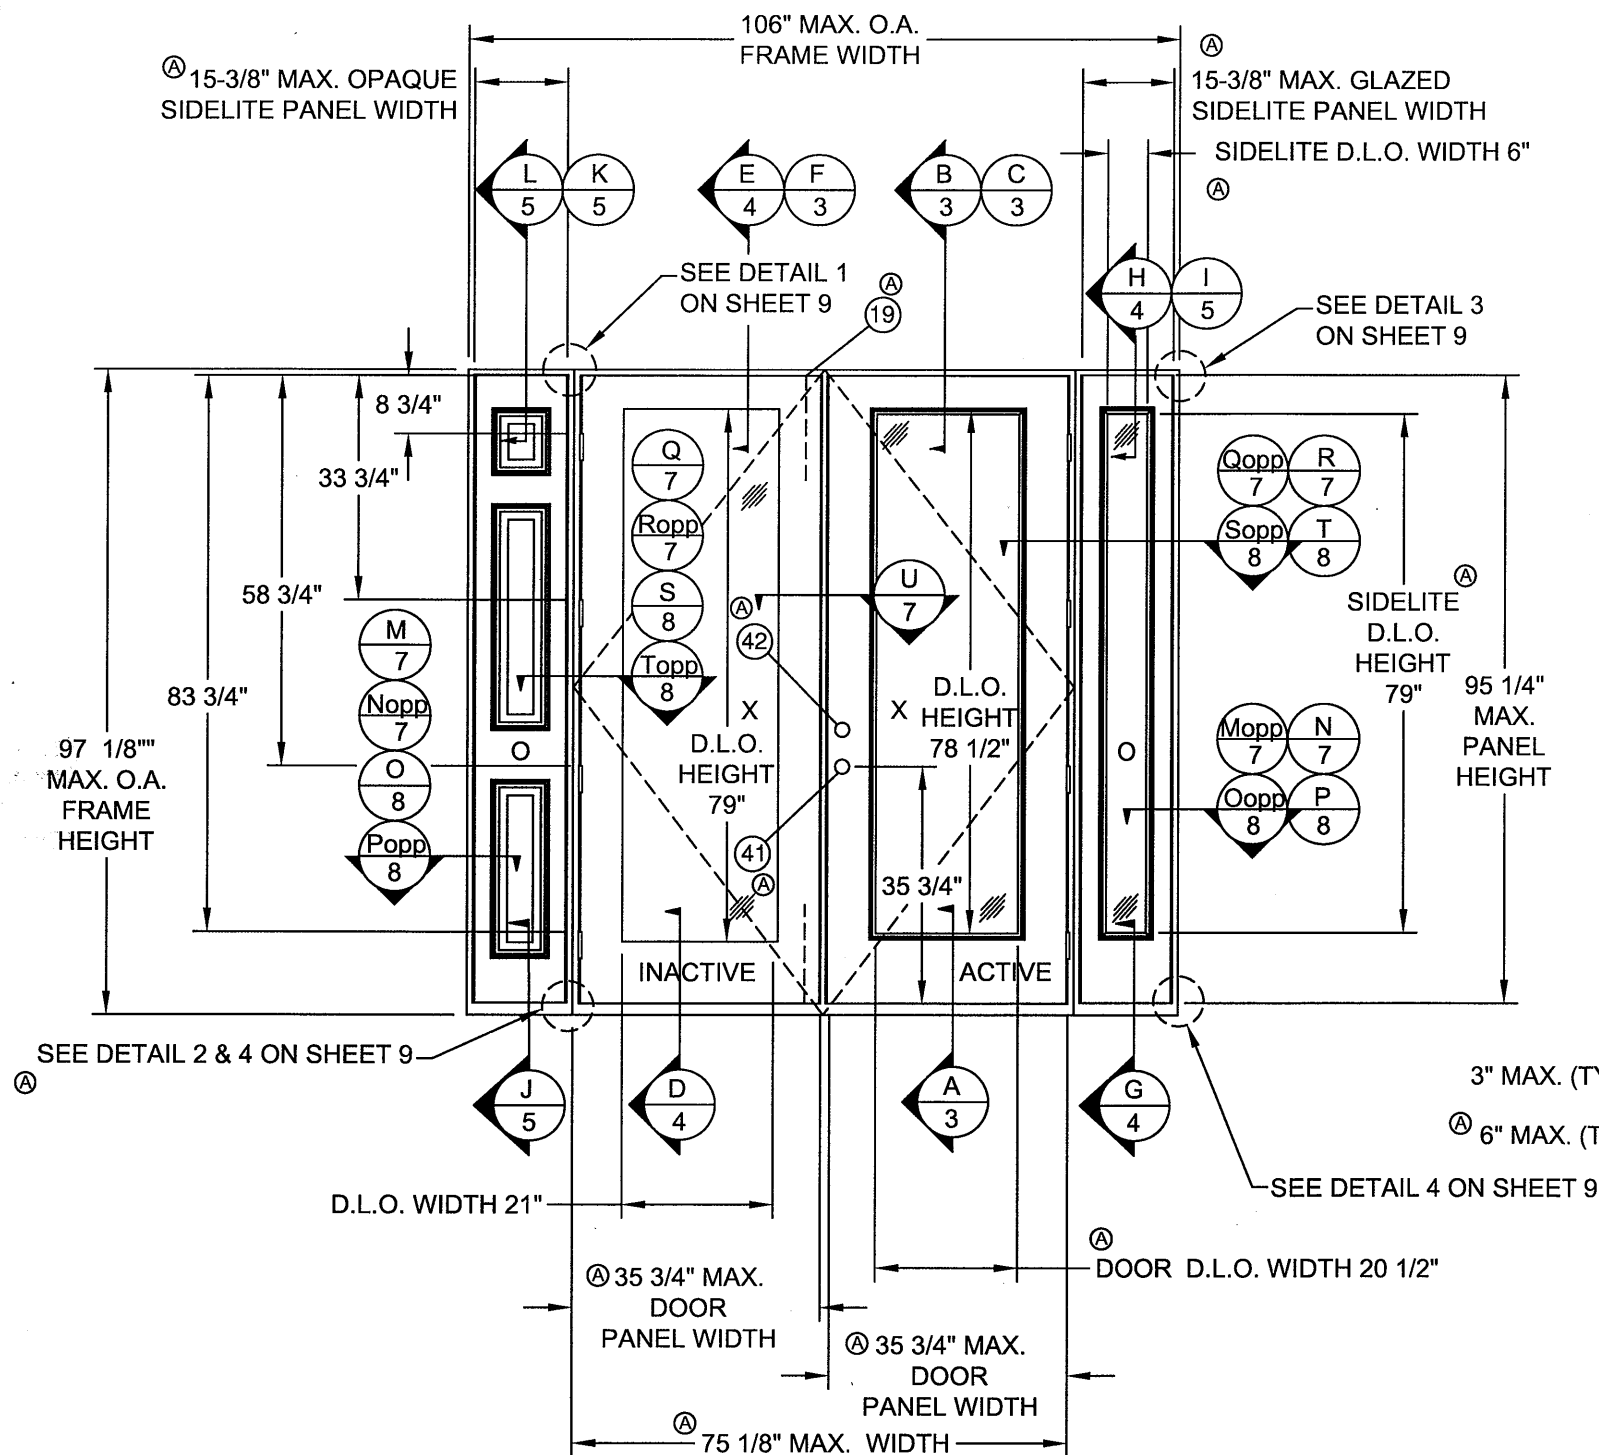

**ELEVATION**  
EXTERIOR VIEW  
(OUTSWING DOORS W/ SIDELITES)

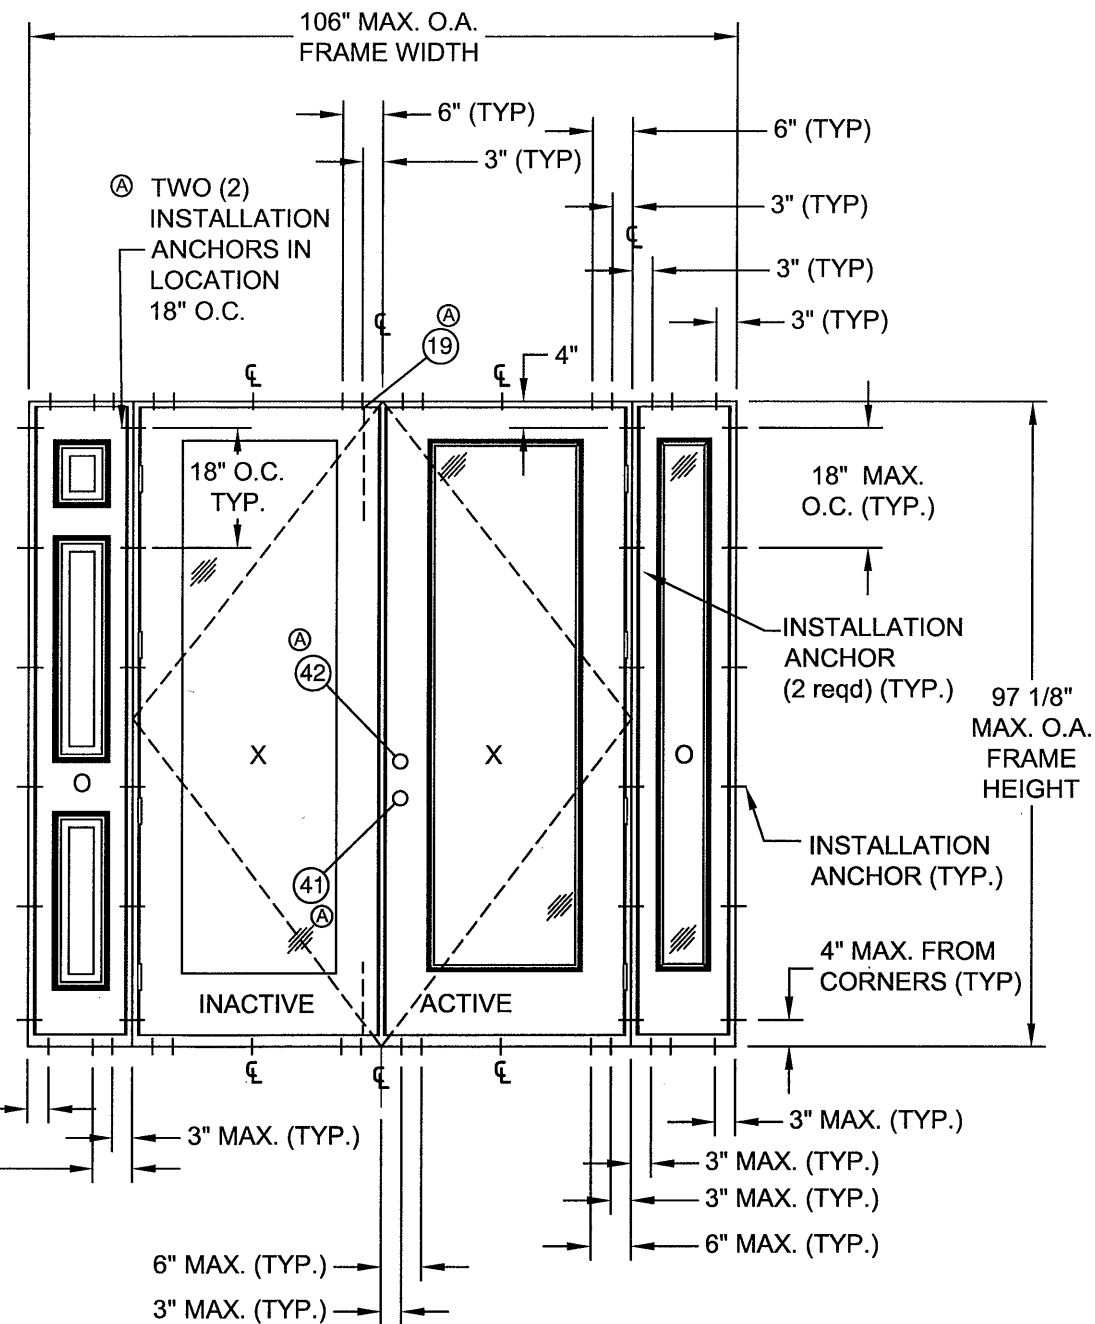

**ANCHOR LAYOUT**  
EXTERIOR VIEW  
(OUTSWING DOORS W/ SIDELITES)

PROJECT #412-0208

**NAN YA PLASTICS**  
8989 NORTH LOOP EAST  
HOUSTON, TX 77029






TITLE: IMPACT 8' GLAZED OUTSWING DOUBLE DOOR W/ SIDELITES  
ELEVATION & ANCHOR LAYOUT

PREPARED BY:	DATE:	DRAWN BY:	SCALE:	REV:	SHEET:
	1/23/09	BB		B	2 OF 11
PTC PRODUCT DESIGN GROUP, LLC 10005 WOODBRIDGE BLVD LONGWOOD, FL 32750 PHONE: 321.690.1788 FAX: 321.690.1789 EMAIL: info@ptc-corp.com					

Robert J. Amoroso, P.E.  
FL P.E. No. 49752

PRODUCT REVISED  
as complying with the Florida  
Building Code  
Acceptance No. 12-06-12.  
Expiration Date 07/23/2014  
By: [Signature]  
Miami Dade Product Control

REV	DESCRIPTION	DATE	BY
B	UPDATE TO 2010 FBC	04/25/12	TJH
A	PER MIAMI-DADE 4/12/09	05/22/09	BB

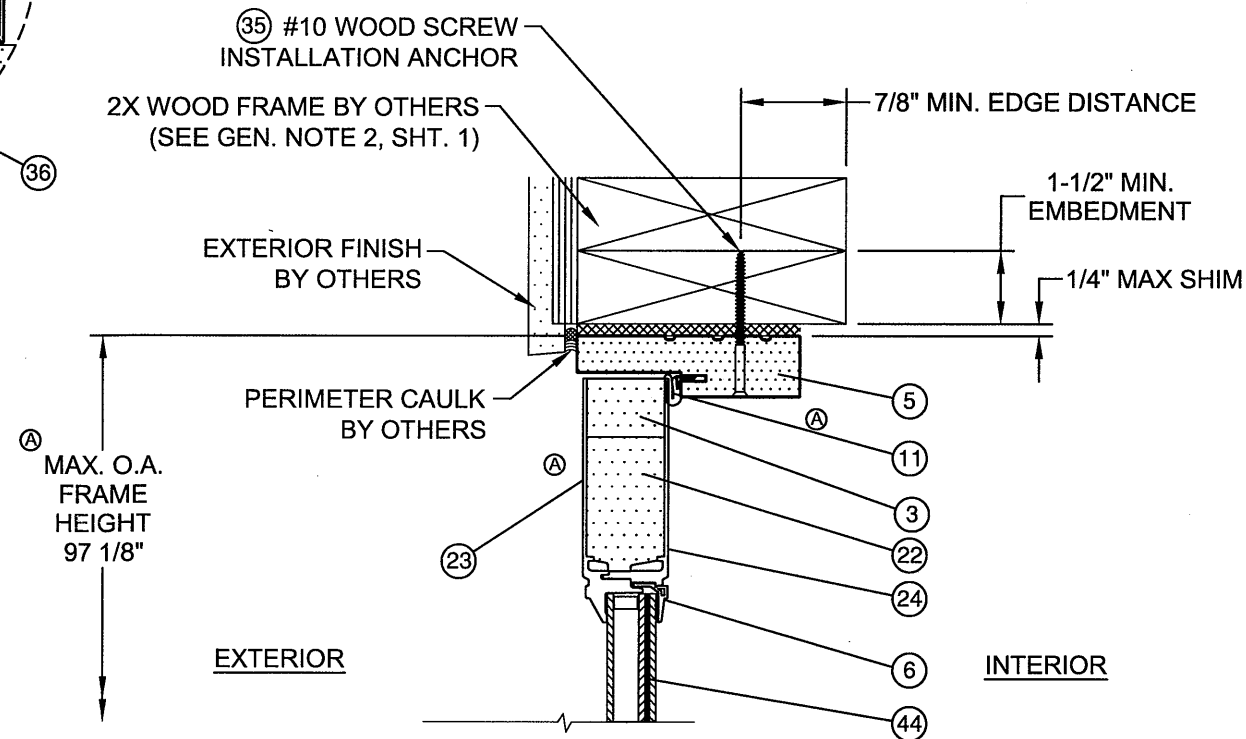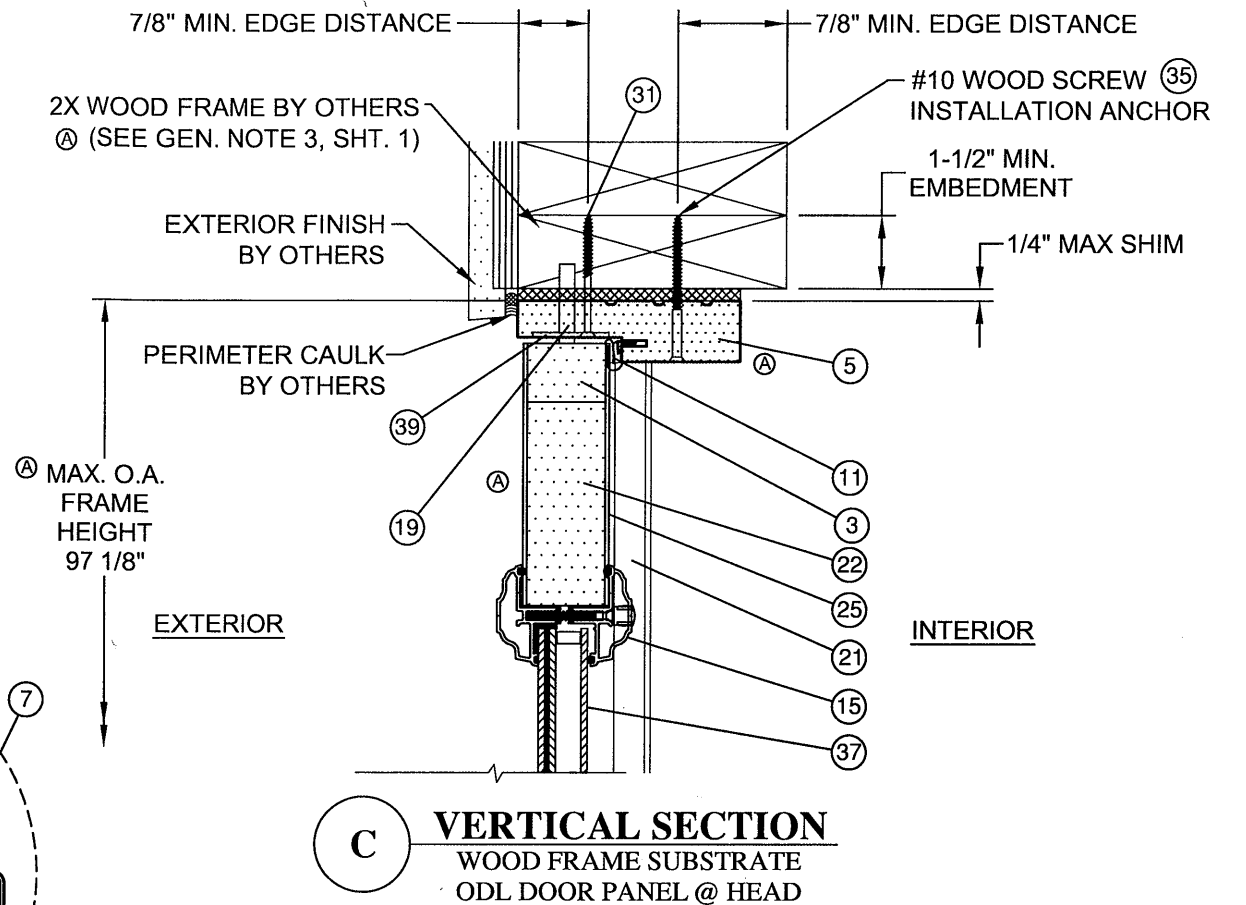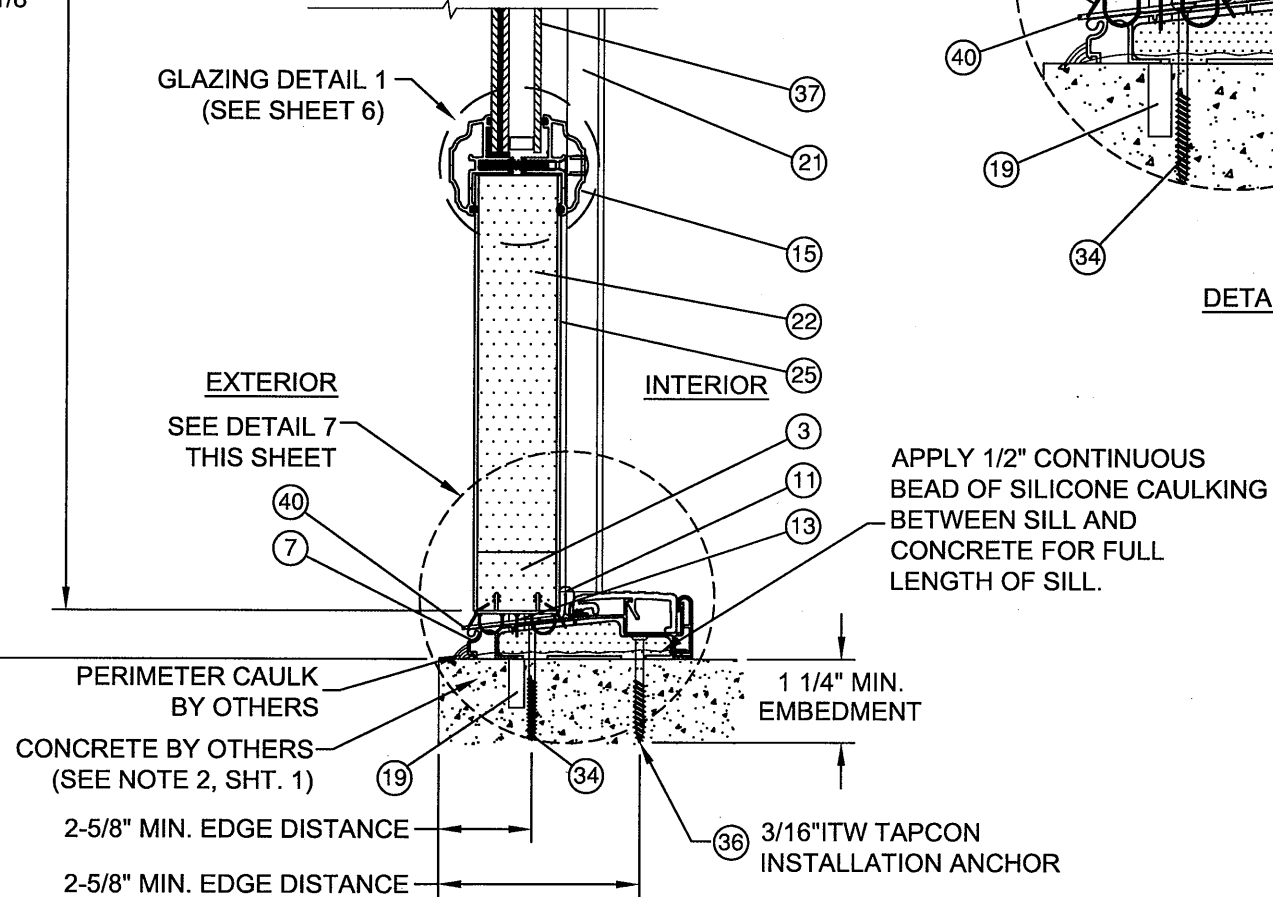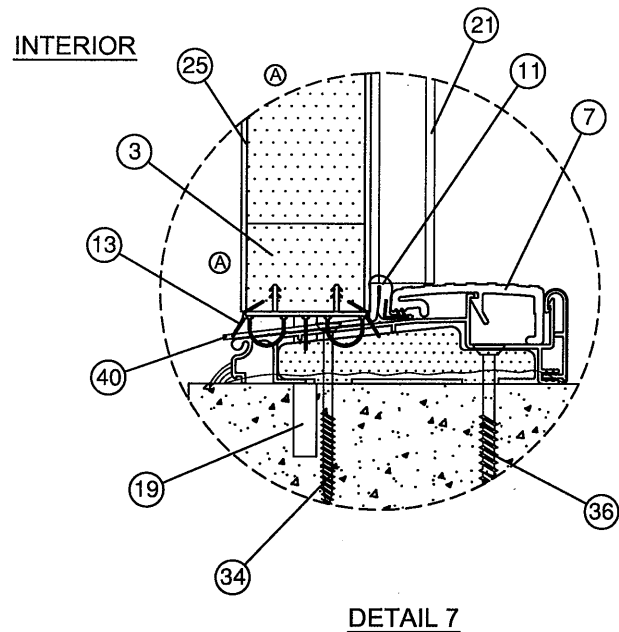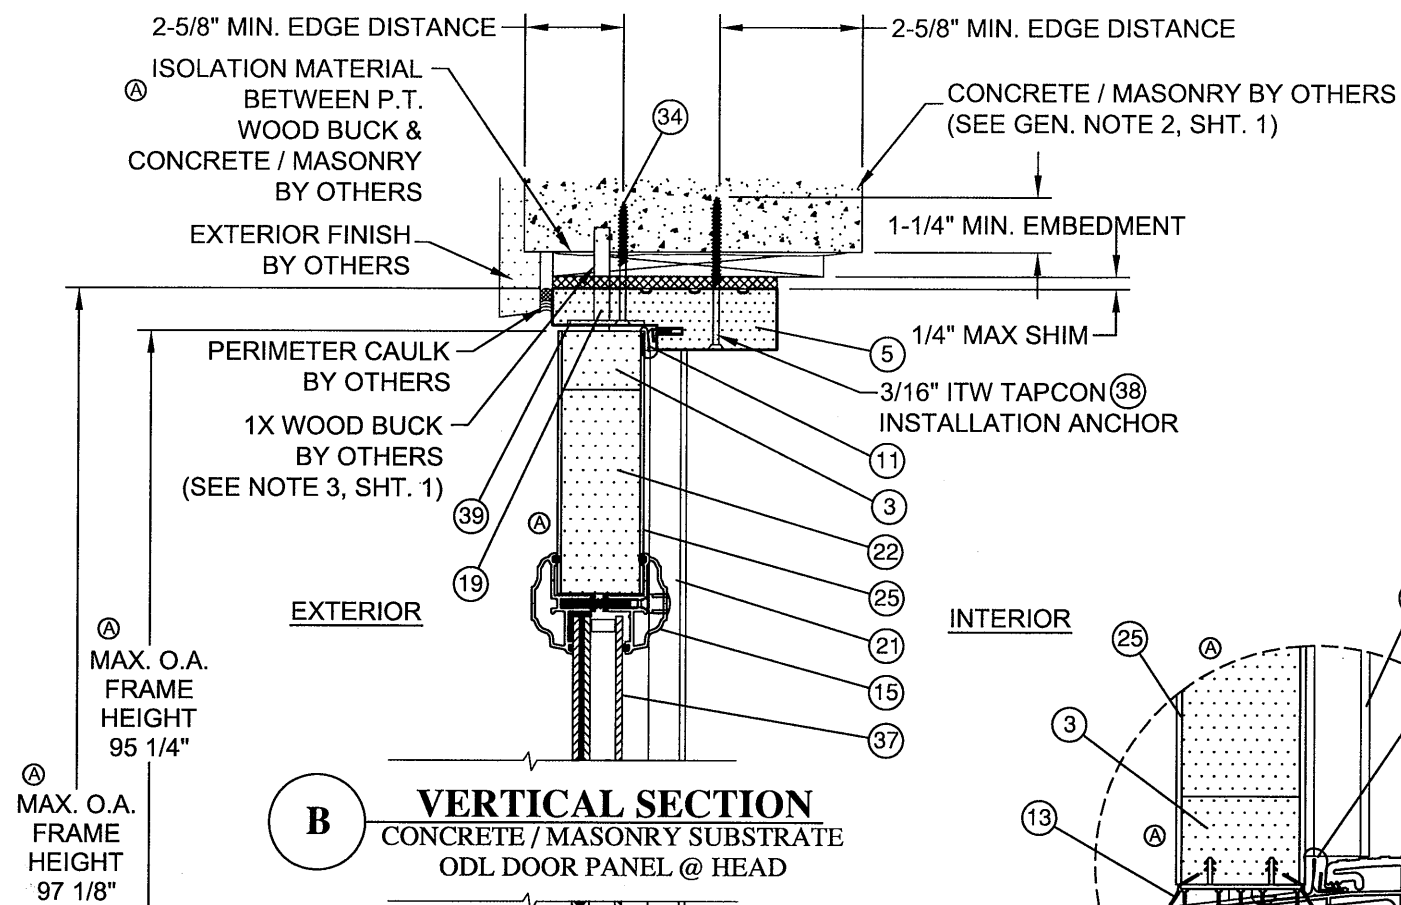

PROJECT #412-0208

NAN YA PLASTICS  
8989 NORTH LOOP EAST  
HOUSTON, TX 77029

TITLE: IMPACT 8' GLAZED OUTSWING DOUBLE DOOR W/ SIDELITES

DATE:	1/23/09
DRAWN BY:	BB
SCALE:	
REV:	B
SHEET:	3 OF 11
DRAWING NO:	NAN0021





Robert J. Amoroso, P.E.  
FL P.E. No. 49752

3 4/12/12

PRODUCT REVISED  
is complying with the Florida  
Building Code  
Acceptance No. 12-0612-1  
Expiration Date 09/21/2014

Miami Dade Product Control



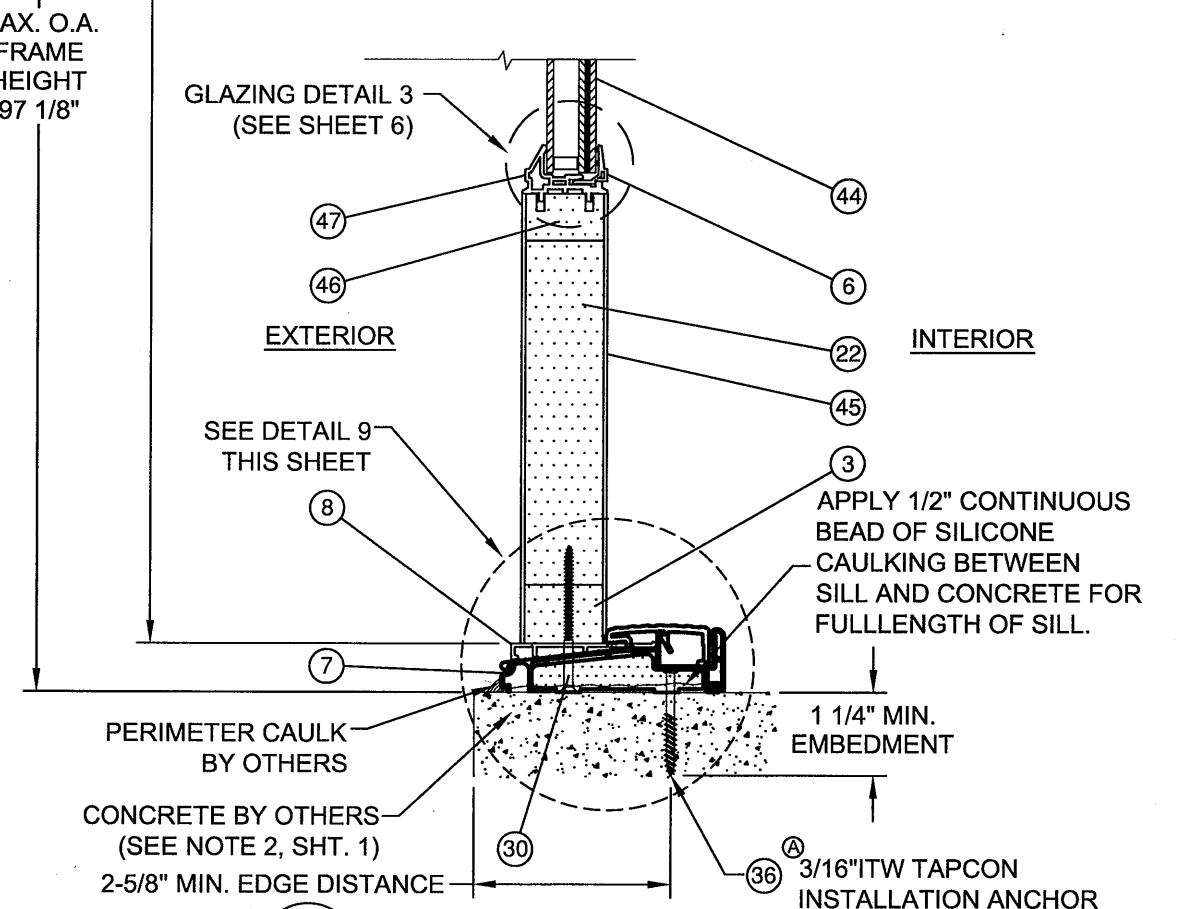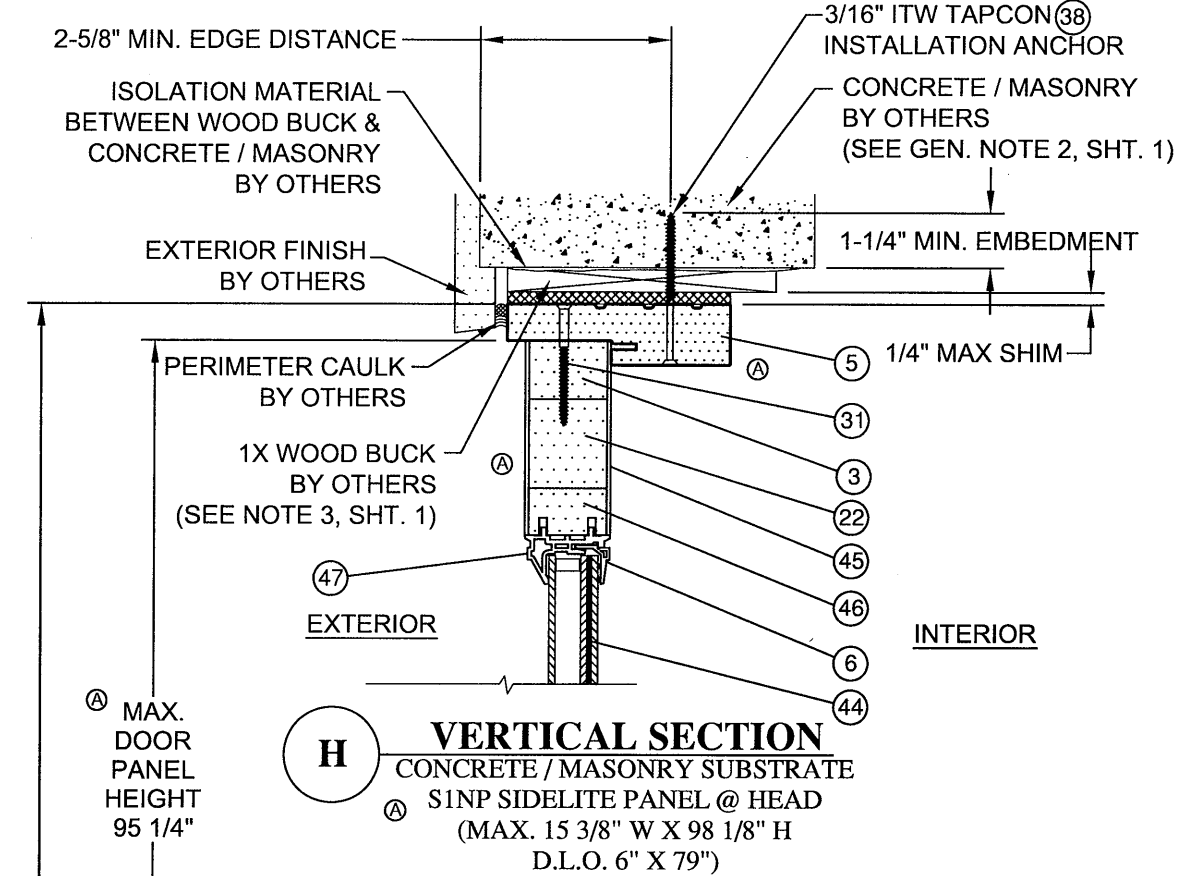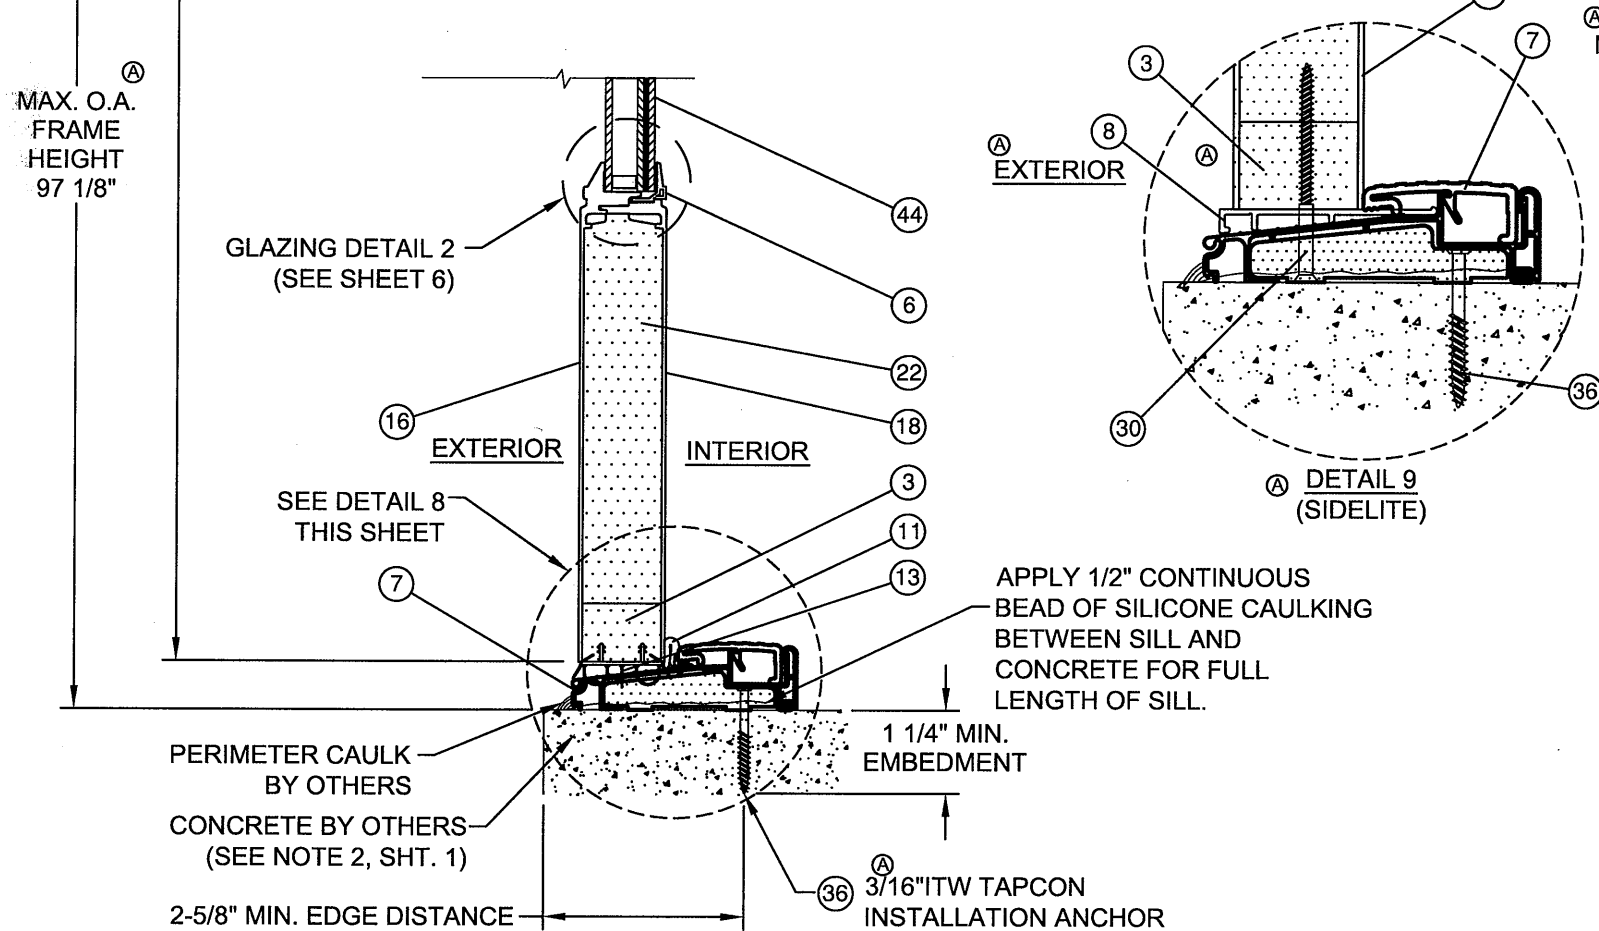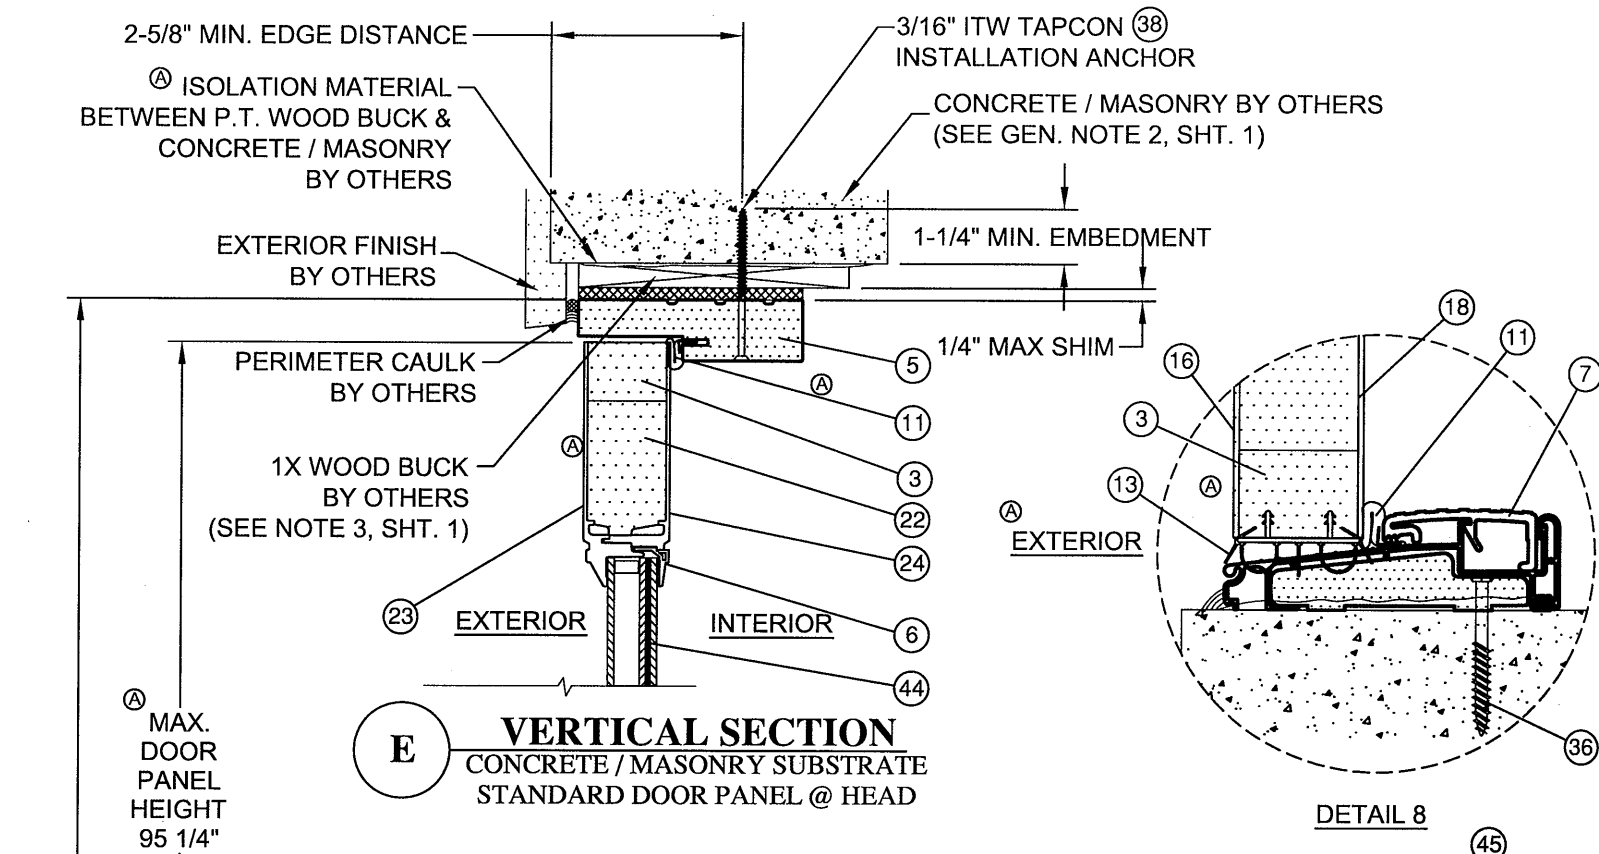

PROJECT #412-0208

NAN YA PLASTICS  
8989 NORTH LOOP EAST  
HOUSTON, TX 77029


TITLE: IMPACT 8' GLAZED OUTSWING DOUBLE DOOR W/ SIDELITES

PREPARED BY: BB  
DATE: 1/23/09  
DRAWING NO: NAN0021  
SHEET: 4 OF 11  
REV: B


PTC PRODUCT DESIGN GROUP, LLC  
PO BOX 920775  
LONGWOOD, FLORIDA 32752  
Phone: 321.690.1788  
Fax: 321.690.1789  
Email: info@ptc-corp.com

Robert J. Amoroso, P.E.  
FL P.E. No. 49752


PRODUCT REVISED  
as complying with the Florida  
Building Code  
Acceptance No. 12-0612.  
Expiration Date 07/26/2014  
By: [Signature]  
Miami Dade Product Control

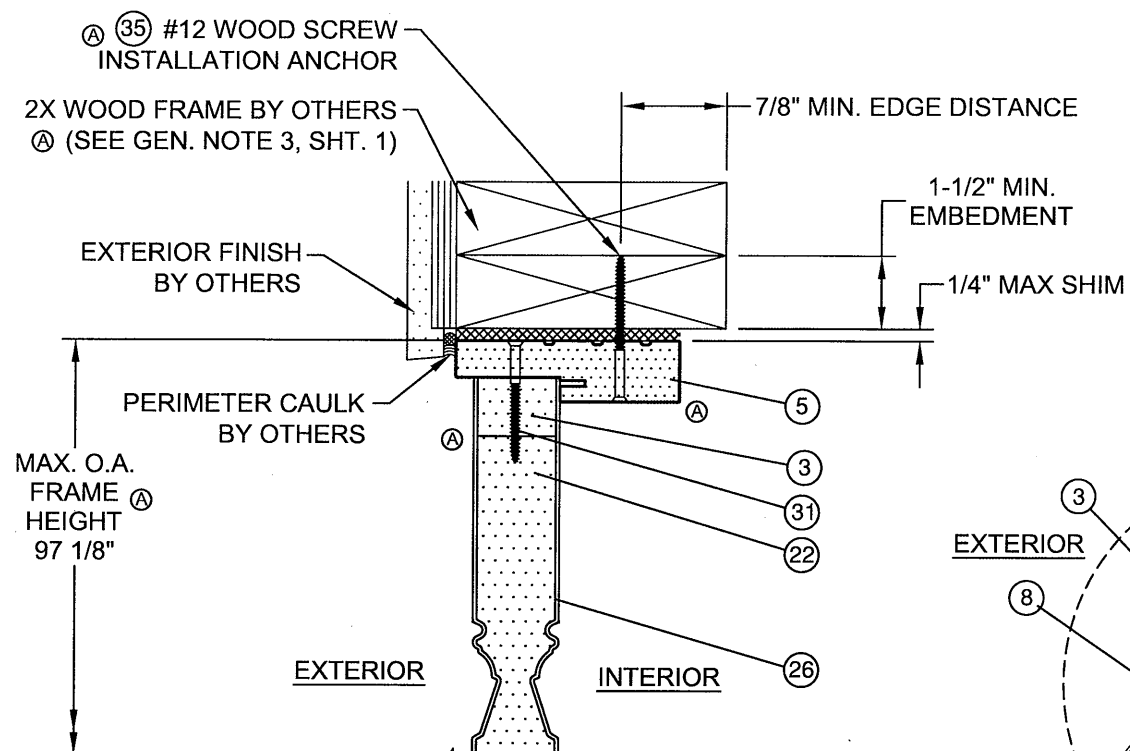


**L** VERTICAL SECTION  
WOOD FRAME SUBSTRATE  
MAX. OPAQUE SIDELITE PANEL  
@ 15 3/8" X 95 1/4" @ HEAD

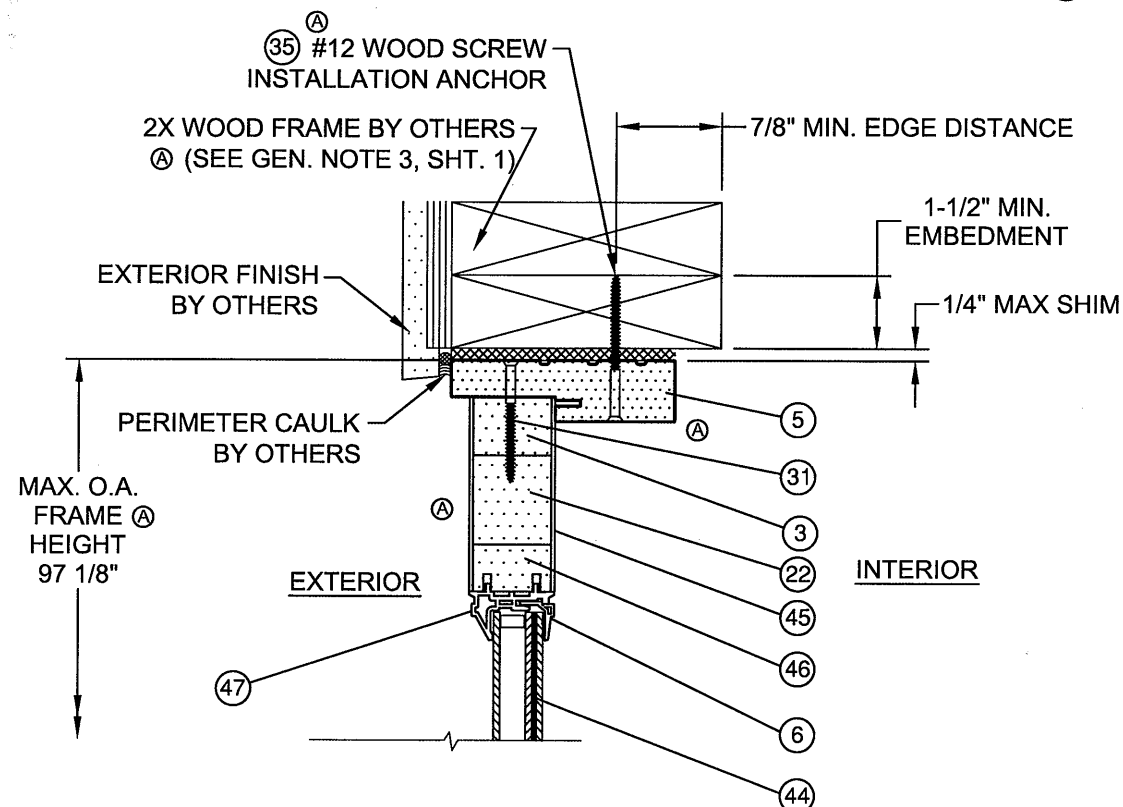


**I** VERTICAL SECTION  
WOOD FRAME SUBSTRATE  
S1NP SIDELITE PANEL @ HEAD  
MAX. D.L.O. 6" X 79"  
MAX. SIDELITE PANEL 15 3/8" X 95 1/4"

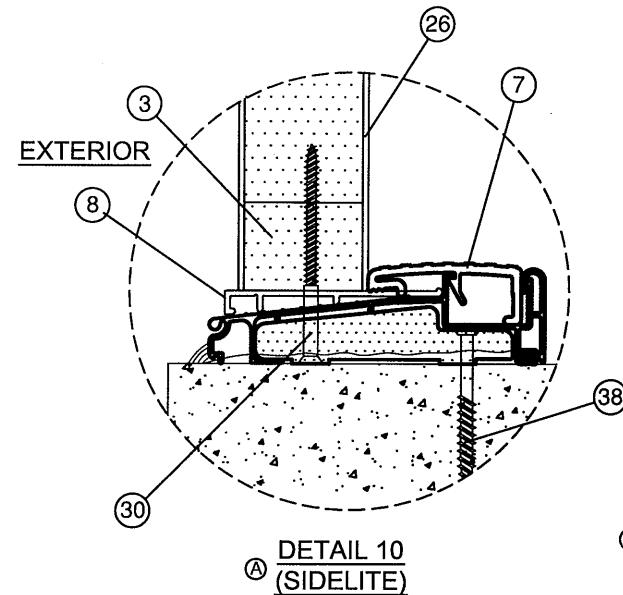

**A** DETAIL 10  
(SIDELITE)

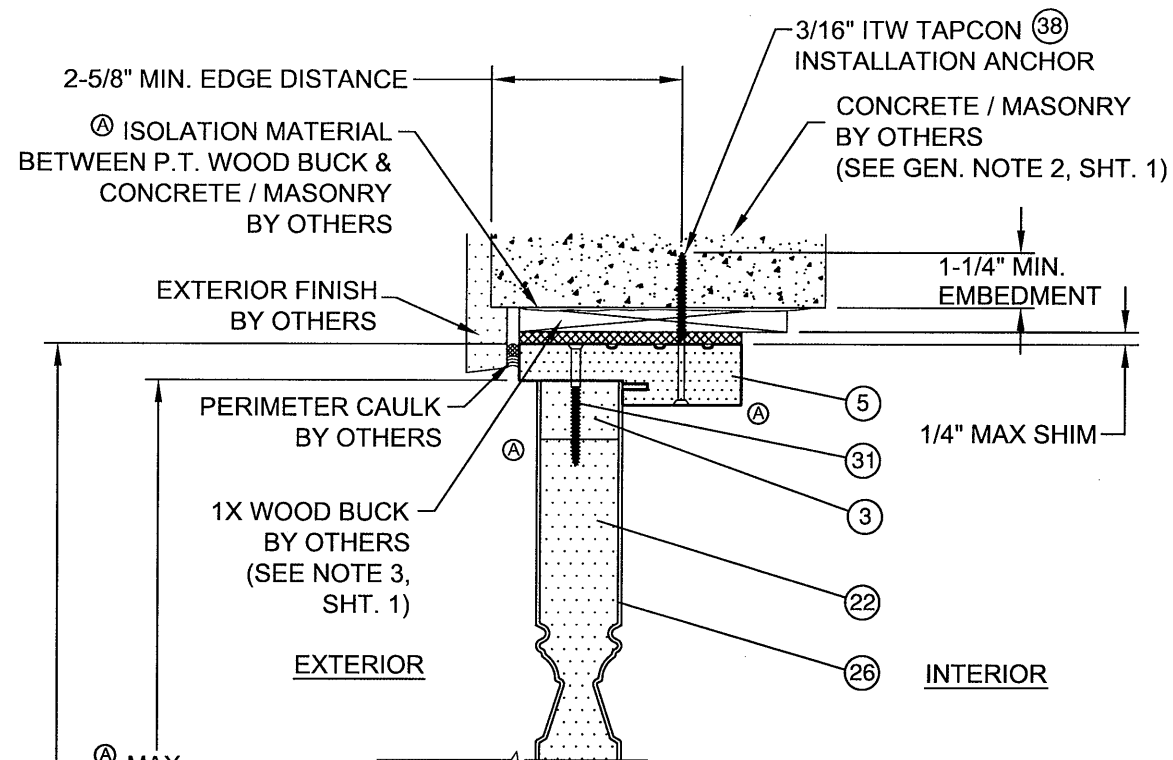

**K** VERTICAL SECTION  
CONCRETE / MASONRY SUBSTRATE  
STANDARD SIDELITE PANEL @ HEAD  
@ MAX. SIDELITE PANEL 15 3/8" X 95 1/4"

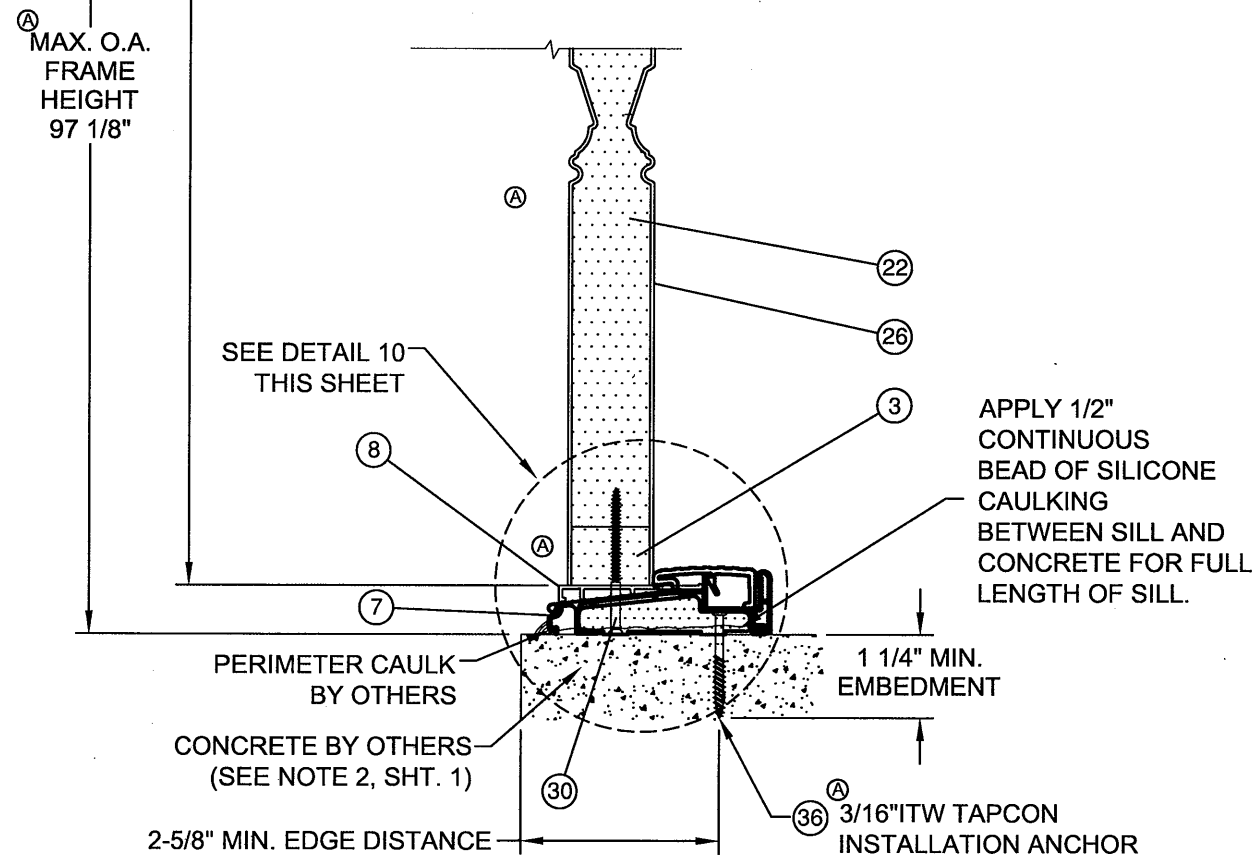

**J** VERTICAL SECTION  
CONCRETE SUBSTRATE  
OPAQUE SIDELITE PANEL @ SILL  
@ MAX. SIDELITE PANEL 15 3/8" X 95 1/4"

PROJECT #412-0208


NAN YA PLASTICS  
8989 NORTH LOOP EAST  
HOUSTON, TX 77029

TITLE: IMPACT 8' GLAZED OUTSWING DOUBLE DOOR W/ SIDELITES


DATE	1/23/09	DRAWING NO.	NAN0021	SHEET	5 OF 11
BY	BB	SCALE		REV	B
DATE	04/25/12	DESCRIPTION	PER MIAMI-DADE	REV	
DATE	05/22/09	DESCRIPTION	4/12/09	REV	
DATE		DESCRIPTION		REV	

Robert J. Amoroso, P.E.  
FL P.E. No. 49752

PRODUCT REVISED  
as complying with the Florida  
Building Code  
Acceptance No. 12-0612-13  
Expiration Date 07/27/2014  
By Miami Dade Product Control

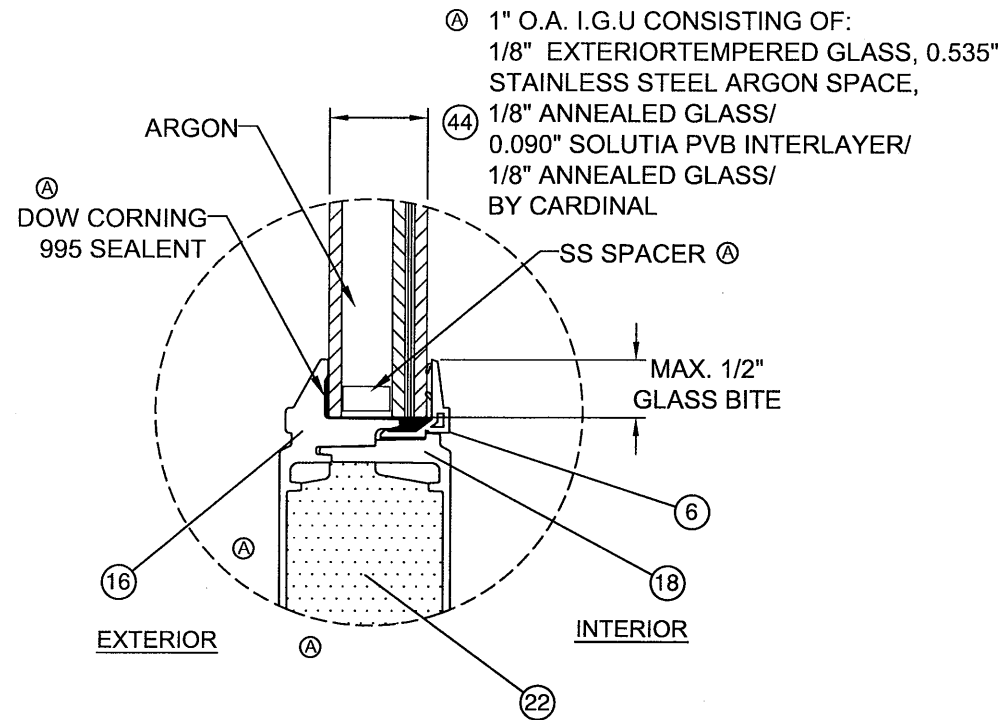


**GLAZING DETAIL 2**

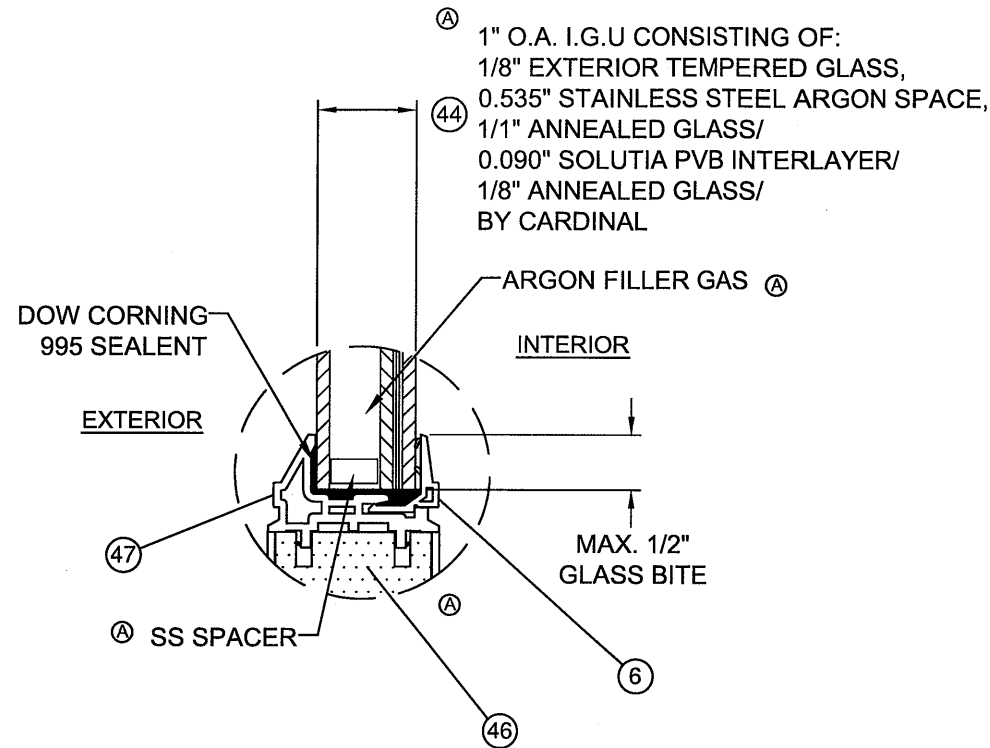


**GLAZING DETAIL 3**

① APPLICABLE TO SIDELITE ONLY  
(MAX. D.L.O. 6" X 79")  
MAX. SIDELITE PANEL 15 3/8" X 95 1/4"

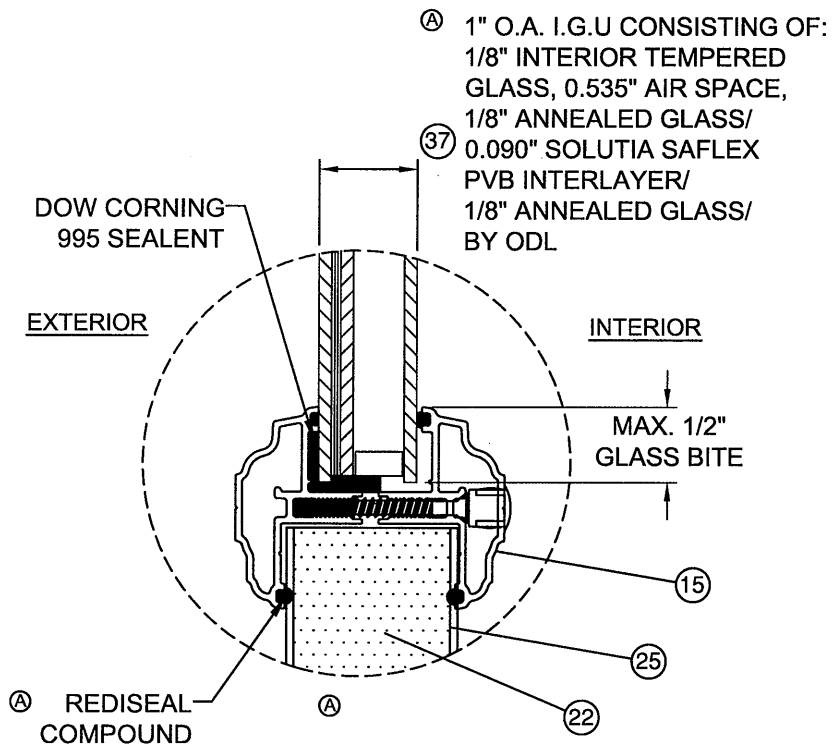


**GLAZING DETAIL 1**

ODL LITE KIT (PER CURRENT NOA)

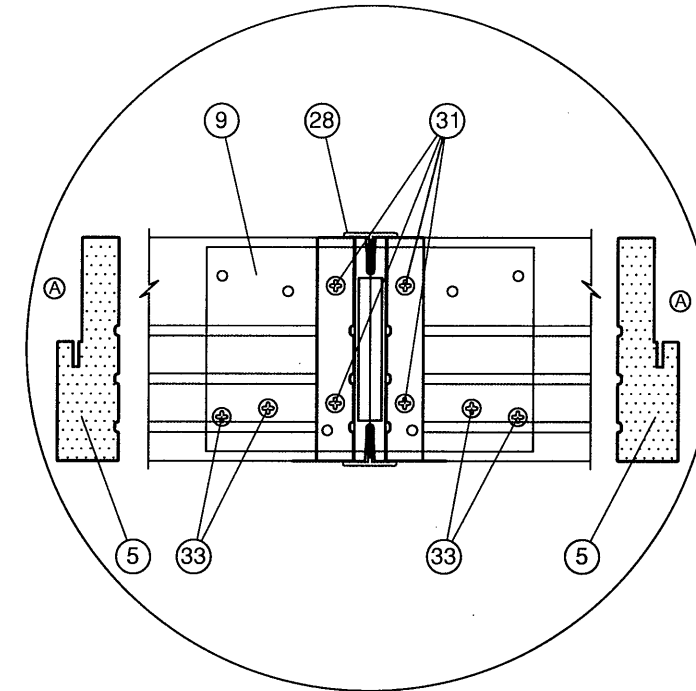

**GLAZING DETAIL 5**

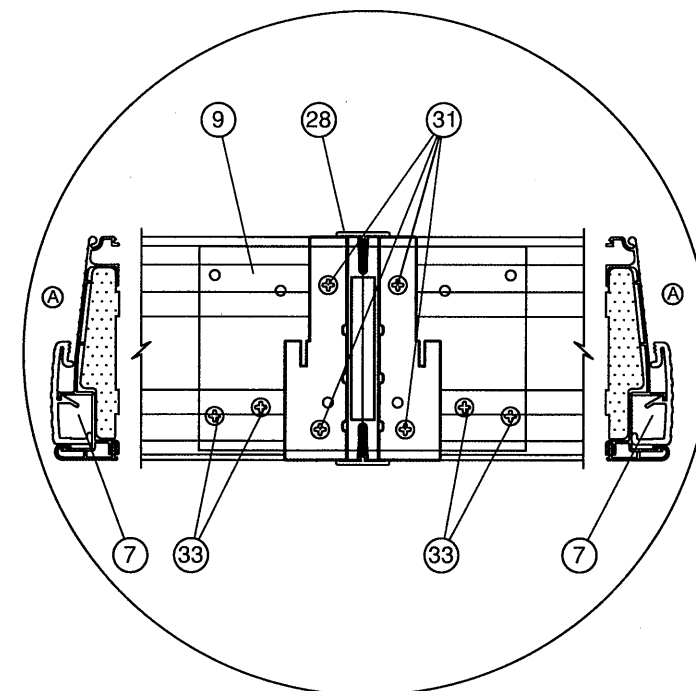

**GLAZING DETAIL 6**

PROJECT #412-0208

NAN YA PLASTICS  
8989 NORTH LOOP EAST  
HOUSTON, TX 77029

TITLE: IMPACT 8' GLAZED OUTSWING DOUBLE DOOR W/ SIDELITES  
GLAZING DETAILS & MULLION PATE DETAILS

PREPARED BY: DATE: 1/23/09  
DRAWN BY: BB  
SCALE: DRAWING NO: NAN0021  
REV: B SHEET: 6 OF 11




Robert J. Amoroso, P.E.  
FL P.E. No. 49752

PRODUCT REVISED  
as complying with the Florida  
Building Code  
Acceptance No. 12-0612.  
Expiration Date 03/22/2014  
By: [Signature]  
Miami Dade Product Control


13  
[Signature]  
4/26/12

BB	05/22/09	DATE
BB	04/25/12	DATE
BB	04/25/12	DATE
BB	04/25/12	DATE

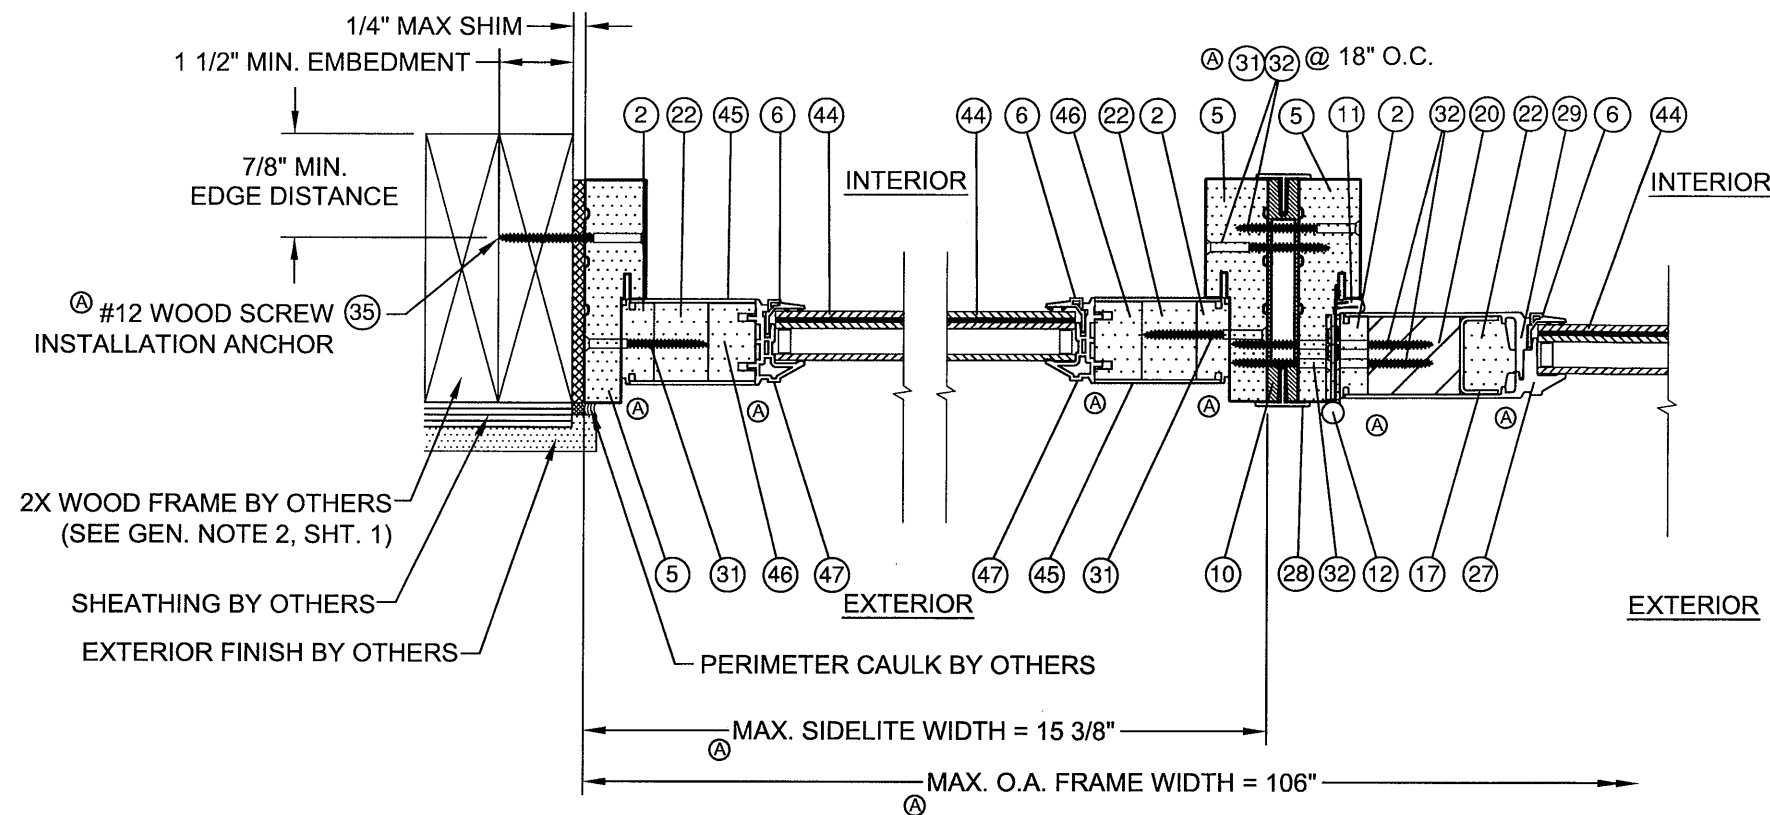

**M HORIZONTAL SECTION**  
WOOD FRAME SUBSTRATE  
S1NP SIDELITE PANEL @ JAMB

**Q HORIZONTAL SECTION**  
MULLION  
STANDARD DOOR & SIDELITE PANELS

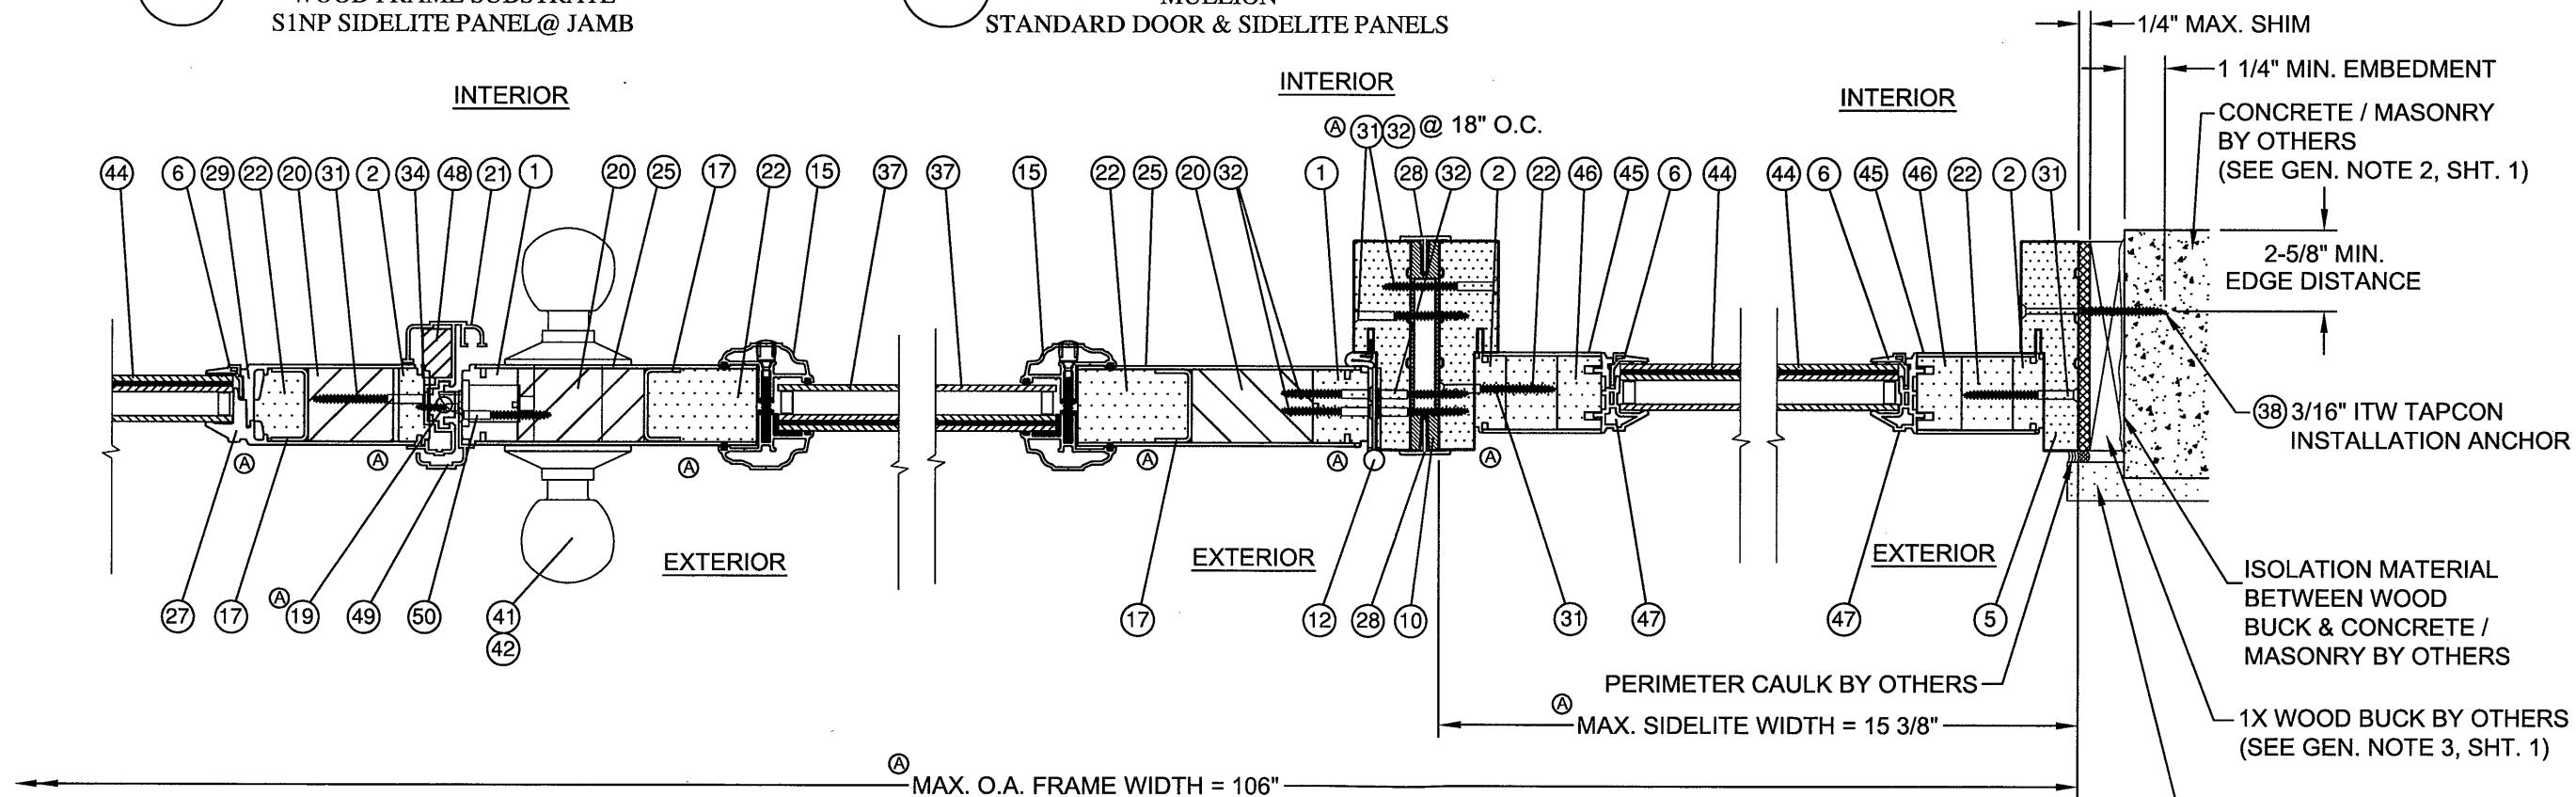

**U HORIZONTAL SECTION**  
MULLION  
STANDARD & ODL DOOR PANELS

**R HORIZONTAL SECTION**  
MULLION  
ODL DOOR & SIDELITE PANELS

**N HORIZONTAL SECTION**  
CONCRETE / MASONRY SUBSTRATE  
S1NP SIDELITE PANEL @ JAMB

PROJECT #412-0208


NAN YA PLASTICS  
8989 NORTH LOOP EAST  
HOUSTON, TX 77029  
TITLE: IMPACT 8' GLAZED OUTSWING DOUBLE DOOR W/ SIDELITES

Robert J. Amoroso, P.E.  
FL P.E. No. 49752

REV	DESCRIPTION	DATE	BY
B	UPDATE TO 2010 FBC	04/25/12	TJH
A	PER MIAMI-DADE 4/12/09	05/22/09	BB


DATE:	1/23/09
DRAWN BY:	BB
SCALE:	NAN0021
REV:	B
SHEET:	7 OF 11

PRODUCT REVISED  
is complying with the Florida  
Building Code  
Acceptance No. 12-0612  
Expiration Date 07/22/2014  
Miami Dade Product Control

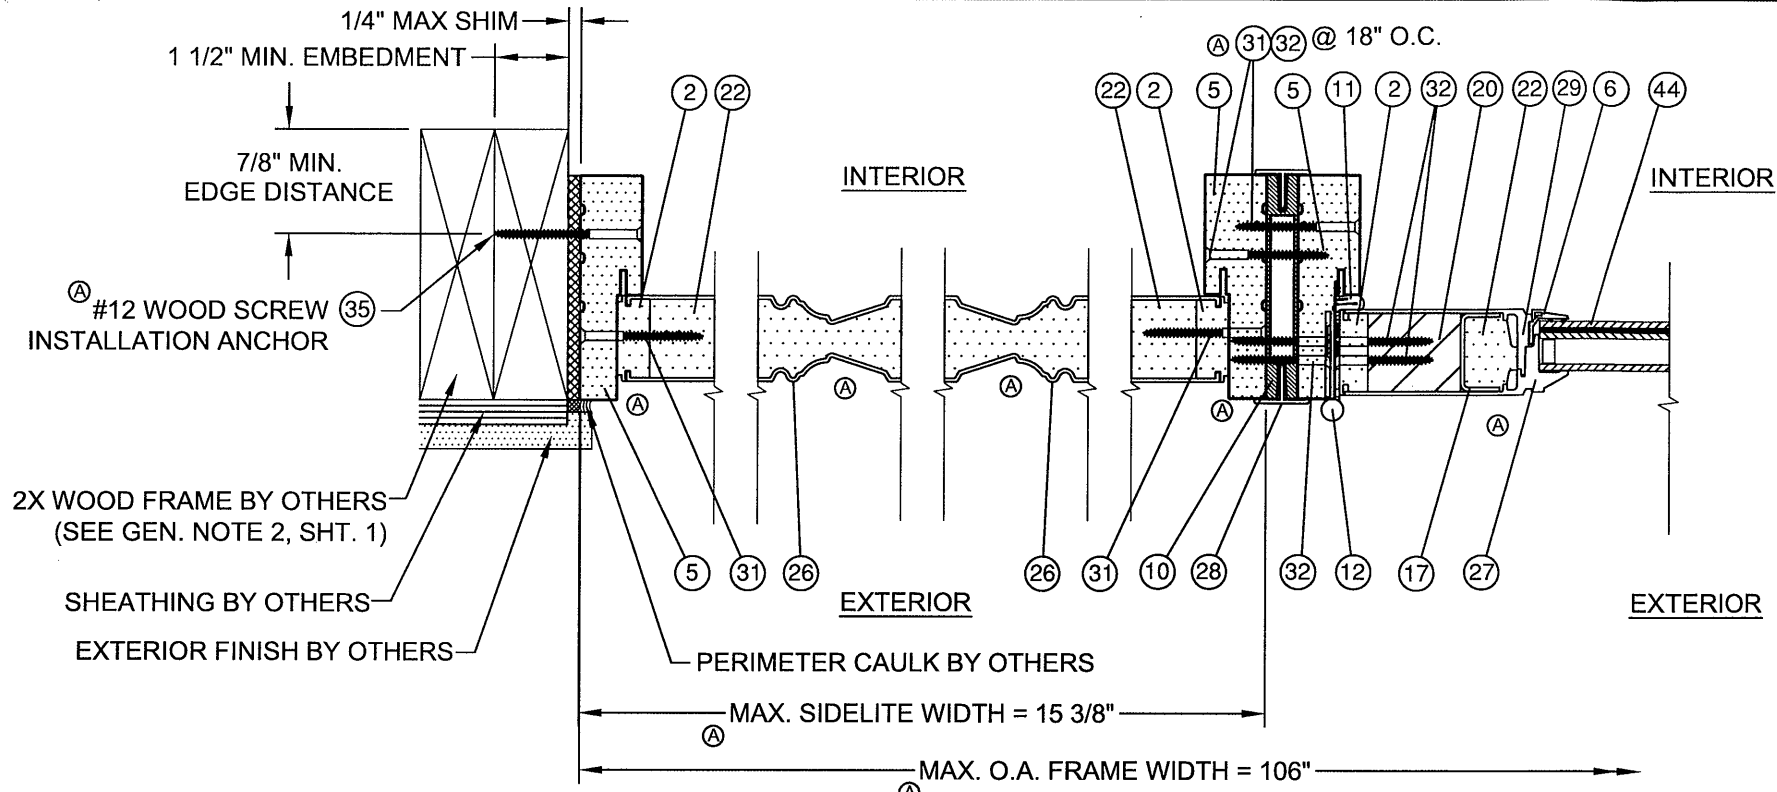

**O HORIZONTAL SECTION**  
WOOD FRAME SUBSTRATE  
OPAQUE SIDELITE PANEL @ JAMB

**S HORIZONTAL SECTION**  
MULLION  
STANDARD DOOR & OPAQUE SIDELITE PANELS

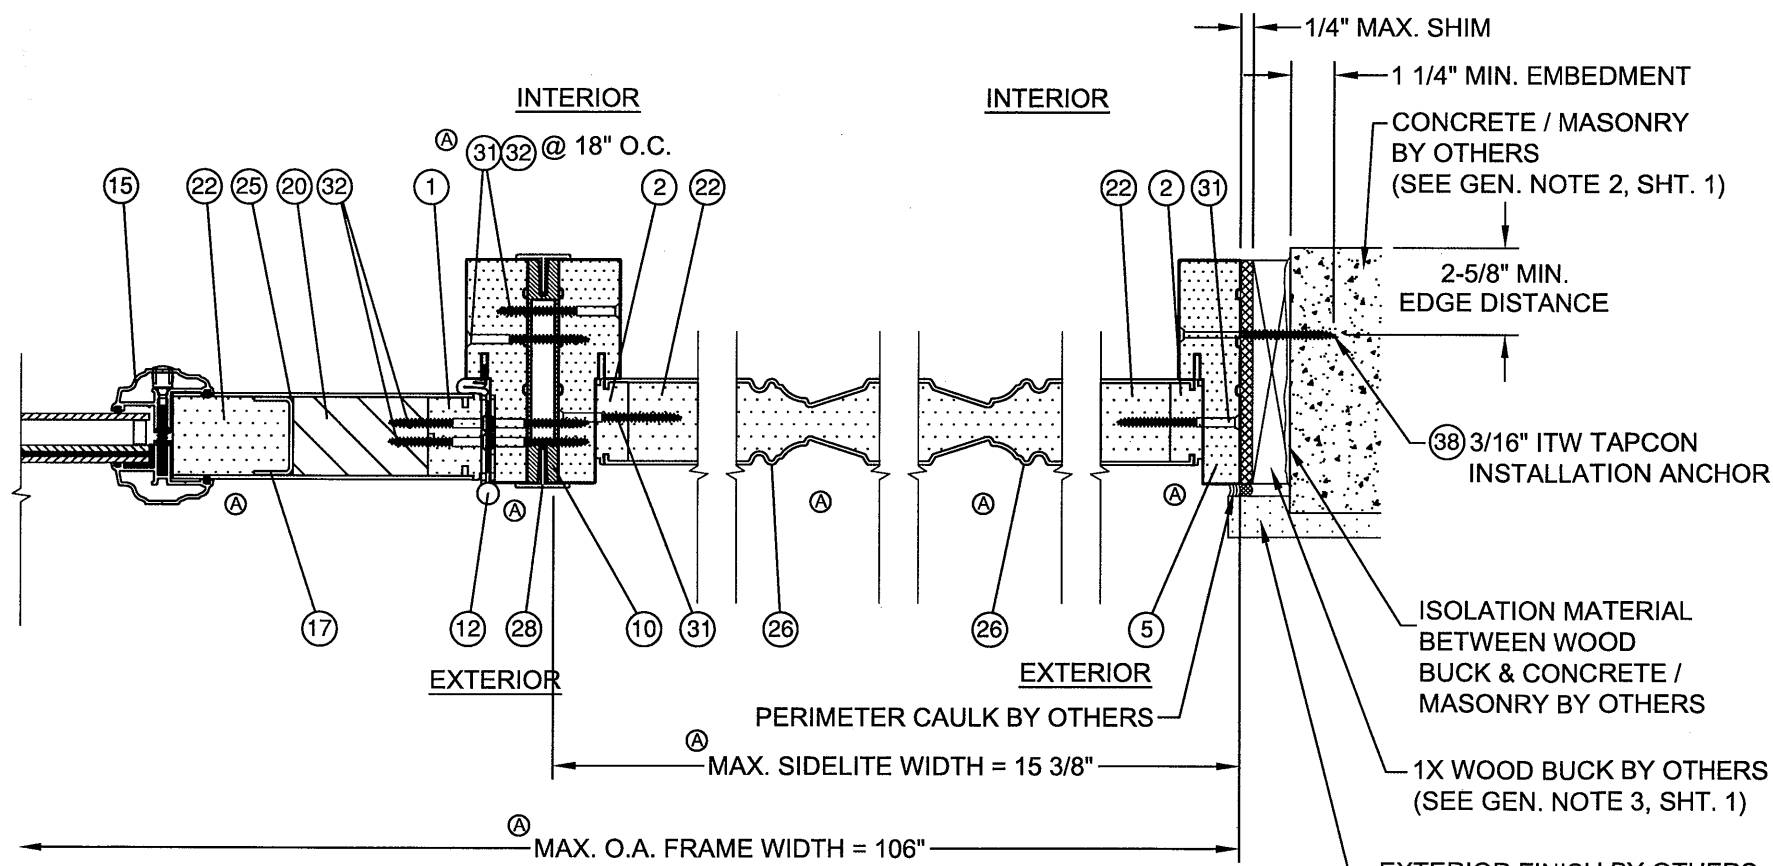

**T HORIZONTAL SECTION**  
MULLION  
ODL DOOR & OPAQUE SIDELITE PANELS

**P HORIZONTAL SECTION**  
CONCRETE / MASONRY SUBSTRATE  
OPAQUE SIDELITE PANEL @ JAMB

PROJECT #412-0208

NAN YA PLASTICS  
8989 NORTH LOOP EAST  
HOUSTON, TX 77029

TITLE: IMPACT 8' GLAZED OUTSWING DOUBLE DOOR W/ SIDELITES


PREPARED BY: BB  
DATE: 1/23/09  
DRAWING NO: NAN0021  
SHEET: 8 OF 11  
REV: B

PTC PRODUCT DESIGN GROUP, LLC  
PO BOX 520775  
LONGWOOD, FLORIDA 32752  
FBPE C.A. NO. 25935  
Phone: 321.690.1788  
Fax: 321.690.1789  
Email: info@ptc-corp.com



Robert J. Amoroso, P.E.  
FL P.E. No. 49752

PRODUCT REVISED  
as complying with the Florida  
Building Code  
Acceptance No. 12-0612-13  
Expiration Date 07/12/16  
By: [Signature]  
Miami Dade Product Control

**FRAME HEAD & MULLION  
DETAIL 1**

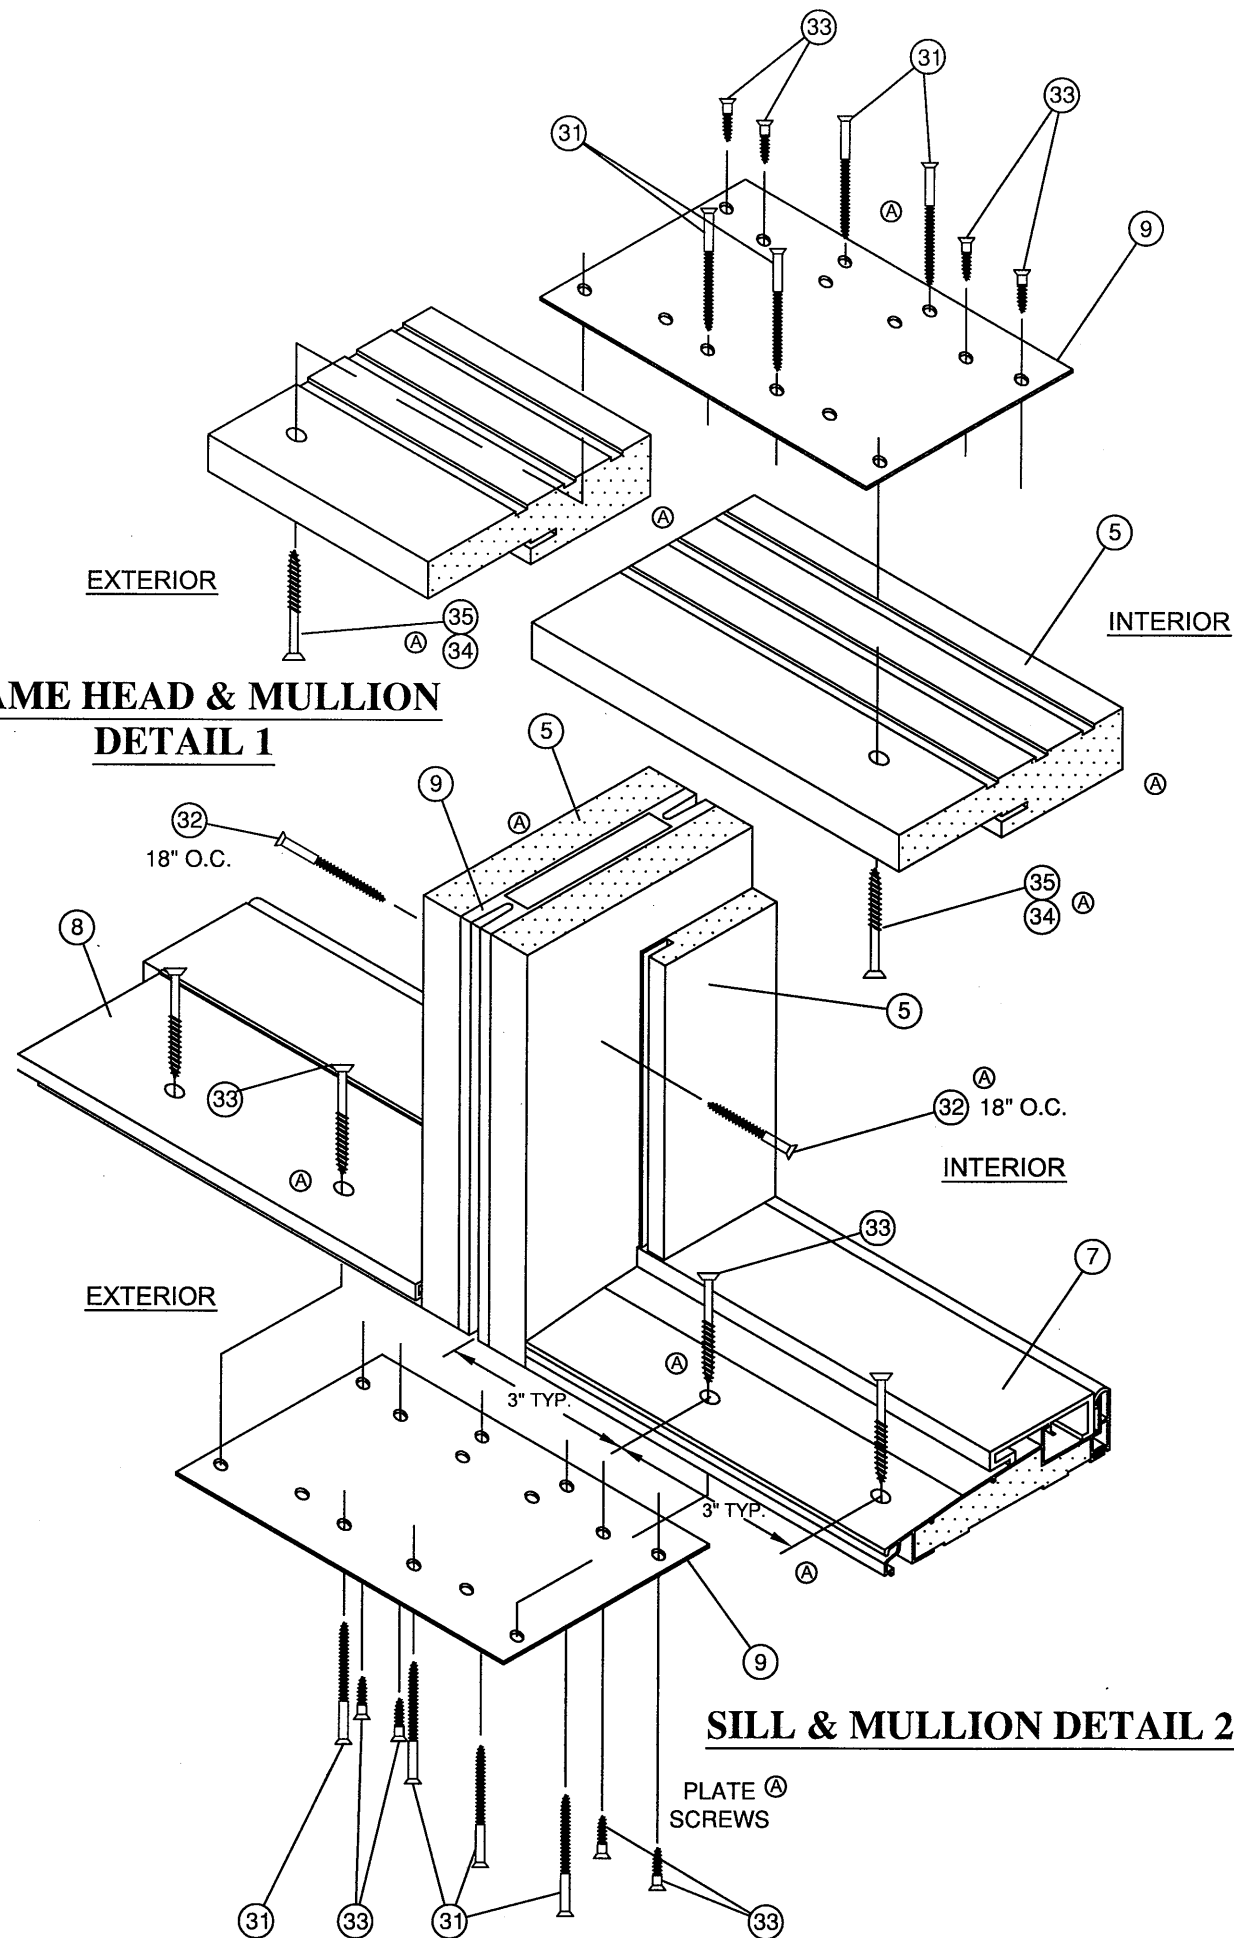

**FRAME HEAD & JAMB  
DETAIL 3**

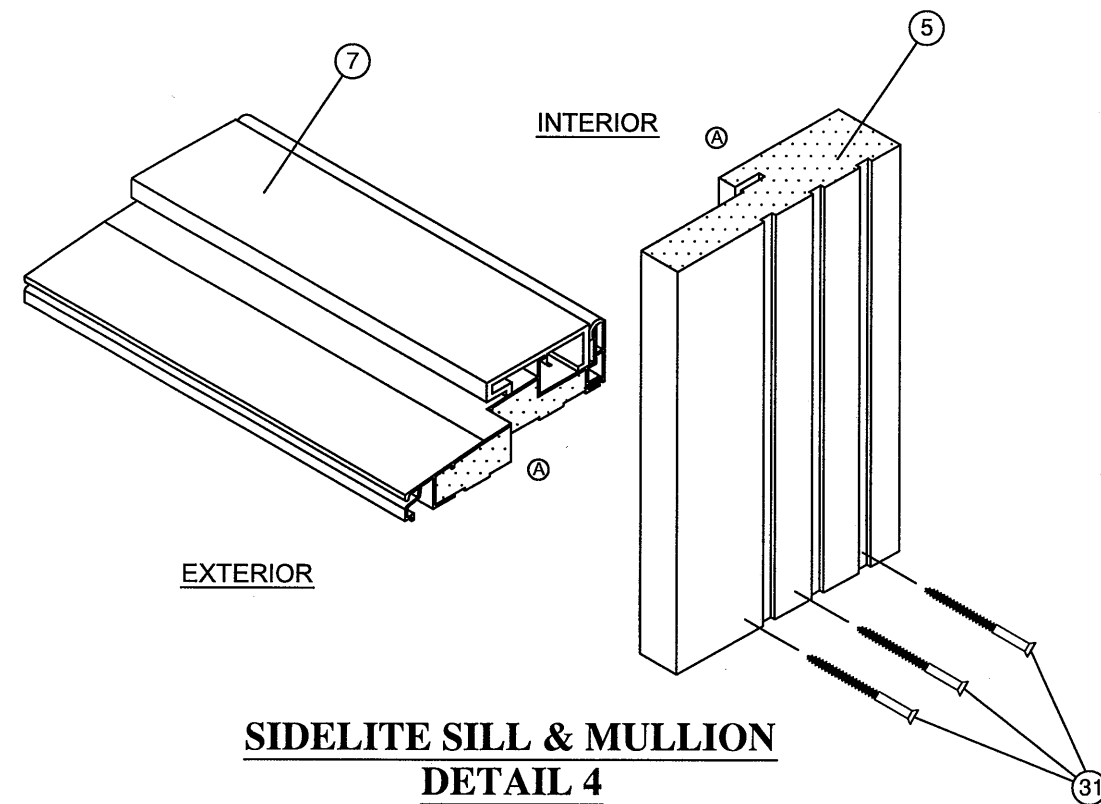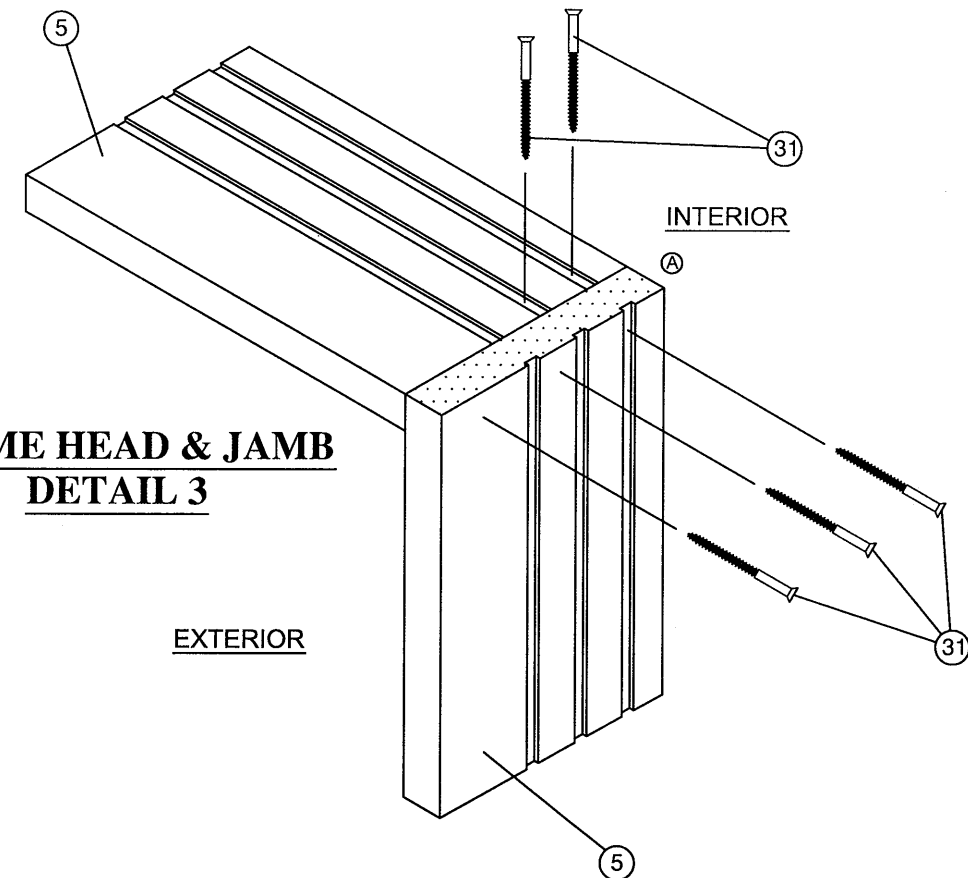

**SIDELITE SILL & MULLION  
DETAIL 4**

PROJECT #412-0208

**NAN YA PLASTICS**  
8989 NORTH LOOP EAST  
HOUSTON, TX 77029

TITLE: IMPACT 8' GLAZED OUTSWING DOUBLE DOOR W/ SIDELITES


PREPARED BY: **FPF**  
PTC PRODUCT DESIGN GROUP, LLC  
PO BOX 520775  
LONGWOOD, FLORIDA 32752  
FBPE CA. NO. 25535  
Phone: 321.690.1788  
Fax: 321.690.1789  
Email: info@fpf-corp.com

DRAWN BY: BB  
SCALE: NAN0021  
REV: B  
DATE: 1/23/09  
DRAWING NO: 1/23/09  
SHEET: 9 OF 11

Robert J. Amoroso, P.E.  
FL P.E. No. 49752

PRODUCT REVISED  
as complying with the Florida  
Building Code  
Acceptance No. 12-0612-13  
Expiration Date 07/22/2014  
By: *[Signature]*  
Miami Dade Product Control

REV	DESCRIPTION	DATE	BY
B	UPDATE TO 2010 FBC	04/25/12	TJH
A	PER MIAMI-DADE 4/12/09	05/22/09	BB

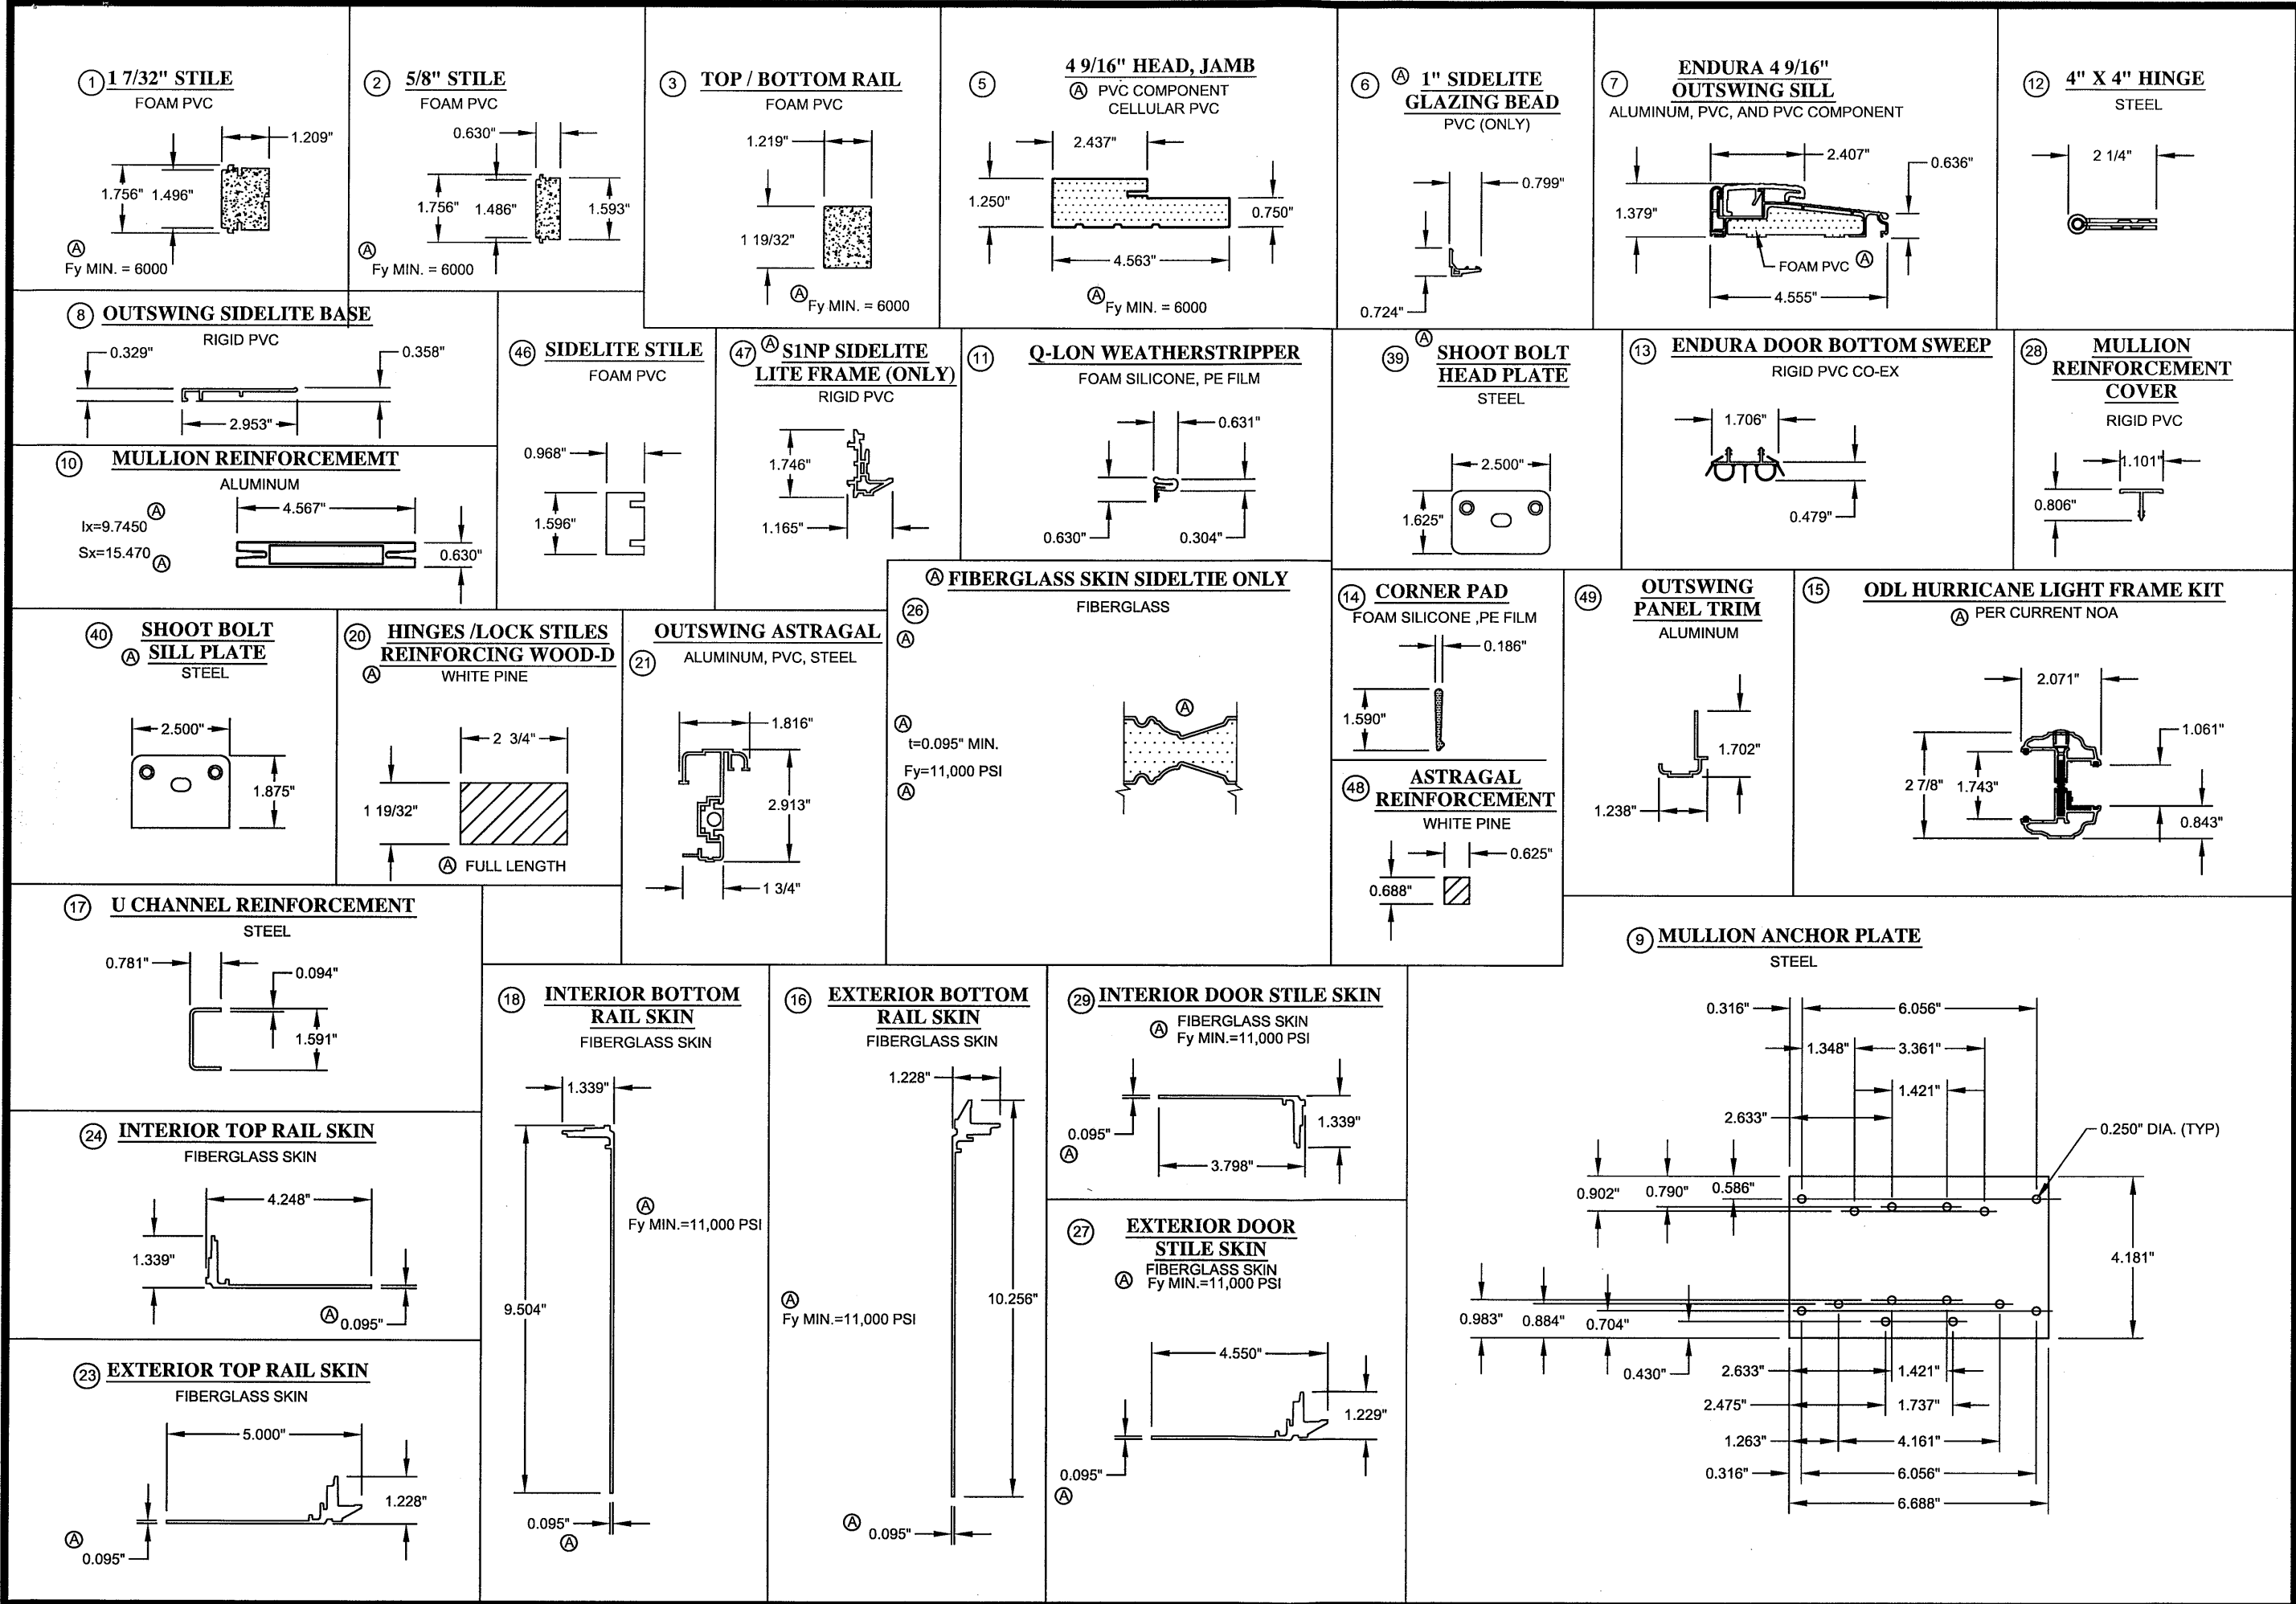

PROJECT #412-0208

NAN YA PLASTICS

8989 NORTH LOOP EAST

HOUSTON, TX 77029

TITLE: IMPACT 8 GLAZED OUTSWING DOUBLE DOOR W/ SIDELITES

PREPARED BY: Robert J. Amoroso, P.E.  
FL P.E. No. 49752

PRODUCT REVISED  
as complying with the Florida  
Building Code  
Acceptance No. 12-0612.13  
Expiration Date 12/31/2014  
By: [Signature]  
Miami Dade Product Control

		TJH	BB	BY
		04/25/12	05/22/09	
B	UPDATE TO 2010 FBC	PER MIAMI-DADE		
A	4/12/09			
REV	DESCRIPTION			DATE

DRAWN BY: BB

DATE: 1/23/09

SCALE: NAN0021

SHEET: 10 OF 11

PTC PRODUCT DESIGN GROUP, LLC

PO BOX 520175

LONGWOOD, FLORIDA 32752

Phone: 321.680.1788

Fax: 321.680.1789

Email: info@ptc-corp.com



